

Name Custom Built Homes

Address 17 Munroe Road

Lexington, Mass.

Location 17 Munroe Road

Kind of Pipe

Size

Size of Main

~~Repair~~ ~~Renewal~~ - New Service

Com. 12-16-46

Location

Date	Material	Amount	Total	Date	Amount
Nov. 30, '46	Labor	19 44	19 44	<i>Nov. 25 '46</i>	<i>Deposited</i> 40 00
	10% Overhead		1 94	<i>Dec 31 '46</i>	<i>Refunded</i> 7 52
	36' - $\frac{3}{4}$ " Copper Tubing @.23		8 28		<i>No-Charge</i> 32 48
	1 - $\frac{3}{4}$ " C x $\frac{1}{2}$ " I.W.H. S. & W		2 82	Nov. 30, '46	Labor 7 56
			32 48	14' - $\frac{3}{4}$ " Copper Tubing @.23	3 22
				1 - $\frac{3}{4}$ " C Corp-cock	2 70
				1 - $\frac{3}{4}$ " C x $\frac{3}{4}$ " C Curb-cock	3 30
				1 - Box & Rod	3 30
				1 - $\frac{1}{2}$ " Straight Tail Piece	50
				1 - $\frac{1}{2}$ " Offset Tail Piece	50
					<u>21 08</u>
	Labor				

Hadley Press, Inc., Lexington

DATE _____

TOWN OF LEXINGTON—BOARD OF PUBLIC WORKS

WATER DIVISION

The undersigned applies for a supply of water at No. _____ St. and hereby agrees to comply with the rules and regulations as now, or at any future time, established by the Board of Selectmen.

Am't. of Estimate \$ _____


Owner _____

Am't. Paid \$ _____

Address _____

Builder _____

Sketch of Service Here

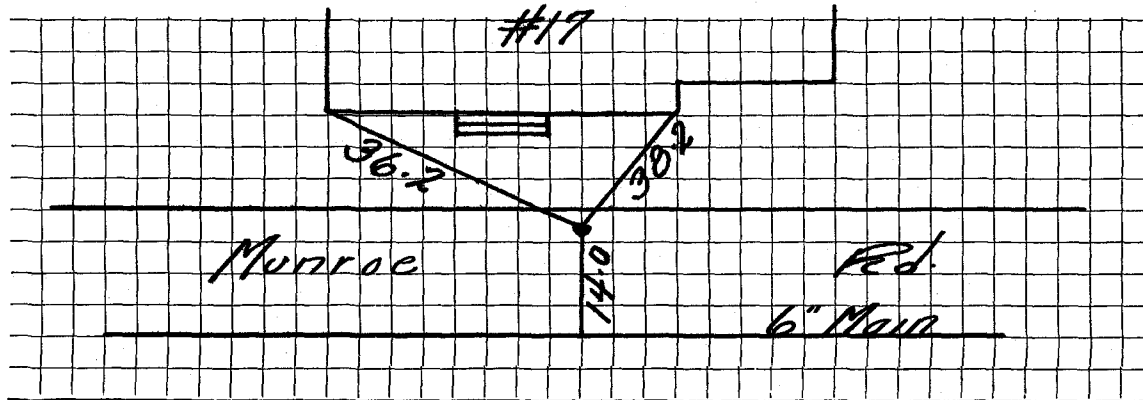

Connection made in _____ Street.

Work completed _____ 19

Remarks: