
| | • | Water | Service Red | cord | | |
|--------------------|---------------|-------------|-------------|------|---|--------|
| Name | Service I | Service No. | | | | |
| Address 2 Mon | NROE | | | | | |
| | NGTON, MA | | | | | |
| Repair - Renewal)- | | | | | | |
| Date | Material | Amount | Total | Date | | Amount |
| 4/22/22 " | TYPE K COPPER | | | | | |
| | | | | | • | |
| 1,, | CURB STOP | | | | | |
| | SPEN-RIGHT | | 1 | | | |
| | | | | | | |
| C | DUFFALO BOX | | | | | |

| 1 / June 1 200 | I THE IT COPPER | | | | | |
|----------------|---------------------|-----------|-----|-----------|--------------|----------|
| | | | | | , | |
| | I" CURB STOP | | | | | |
| | OPEN-RIGHT | | | | | |
| | | | | | | |
| | BUFFALO BOX | | | | | |
| | | | | | | |
| | 3/4" to 1" COUPLING | | | · <u></u> | | |
| <u> </u> | ` | | · . | | | |
| <u> </u> | | | | | | |
| | | | | | <u> </u> | <u>.</u> |
| | · | | | | | |
| | | | | | | |
| | | | | | | |
| | | · · · · · | | | | |
| | | | | | | |
| | | | | | | |

Date: 4/22/22

TOWN OF LEXINGTON - BOARD OF PUBLIC WORKS WATER DIVISON

SKETCH OF SERVICE HERE

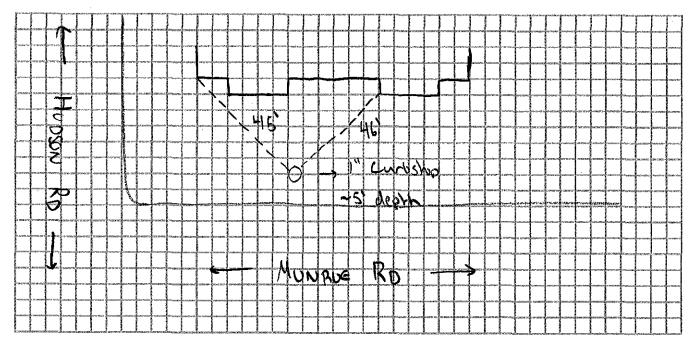

| Connection made in: | MUNROE P | O | Street. | Work completed: | |
|---|----------------------------|--|--|--|--|
| Remarks: TNSTA | ued By | Kzely | EXCAVATION | от пользоння да принцена по почени поряд под принцена да принцена на принцена на принцена на принцена на принц | न्या प्रकार होते हैं। यह प्रकार के वर्ष का स्वार हो जा तथा होते हैं के अपने स्वार है है अपने स्वार है है असर ह |
| чээснэээүдэнгийникиныканыканындыгаруу | f | • | | | остроння сторителя посущения види радичения до приняти поличения по приняти и проделжения по приняти и проделж |
| ՊԱՍՍԱԱԱԱԱԱԱՄԵՐԻ ՄԵՐԵՐԵՐԵՐԵՐԵՐԵՐԵՐԵՐԵՐԵՐԵՐԵՐԵՐԵՐԵՐԵՐԵՐԵՐ | попполиминая муническая по | Matthesterishingerenes retronscrivingeren (den bester se | еколамотивичного принципального прин | | |
| | | | | | |