

Name Custom Built Homes

Service No. 108 3215

Address 21 Munroe Road

#2586

Lexington, Mass.

Location 21 Munroe Road

Kind of Pipe

Size

Size of Main

Repair—Renewal—New Service

Com. 12-16-46

Location

Date	Material	Amount	Total	Date	Amount
Nov. 30, '46	Labor	21 60	21 60	Nov. 25 '46	40 00
	10% Overhead		2 16	Dec. 31 '46	2 66
	40' - $\frac{3}{4}$ " Copper Tubing @ .23		9 20		37 84
	1 - $\frac{1}{4}$ " C x $\frac{1}{2}$ " I.W.H. S. & W.		2 82	Nov. 30, '46	6 48
	2 - $\frac{1}{4}$ " C x $\frac{3}{4}$ " C Unions (2 parts) z		1 56	12' - $\frac{3}{4}$ " Copper Tubing @ .23	2 76
			37 34	1 - $\frac{1}{4}$ " C Corp-cock	2 70
				1 - $\frac{1}{4}$ " C x $\frac{3}{4}$ " C Curbpcock	3 30
				1 - Box & Rod	3 30
				1 - $\frac{3}{4}$ " C x $\frac{3}{4}$ " C Union (2 parts)	78
				1 - $\frac{1}{2}$ " Offset Tail Piece	50
				1 - $\frac{1}{2}$ " Straight Tail Piece	50
					20 32
	Labor				

DATE _____

TOWN OF LEXINGTON—BOARD OF PUBLIC WORKS

WATER DIVISION

The undersigned applies for a supply of water at No. _____ St. and hereby agrees to comply with the rules and regulations as now, or at any future time, established by the Board of Selectmen.

Am't. of Estimate \$ _____


Owner _____

Am't. Paid \$ _____

Address _____

Builder _____

Sketch of Service Here

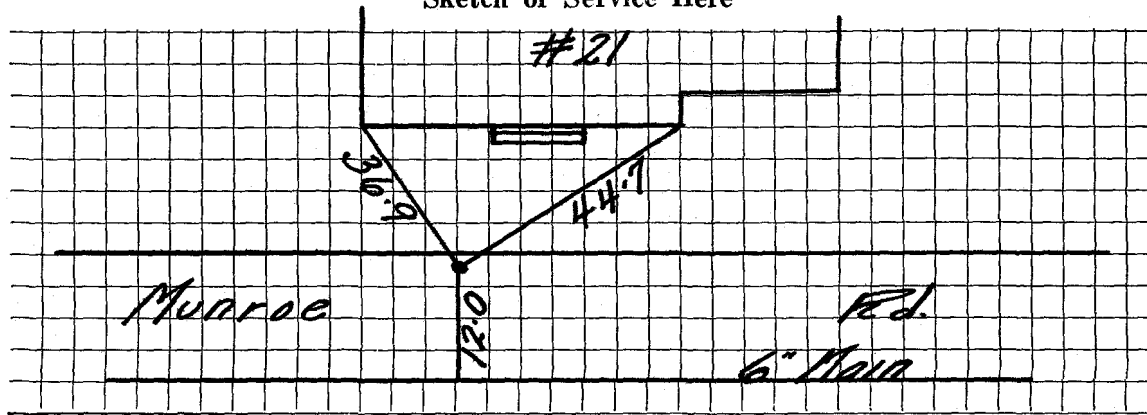

Connection made in _____ Street.

Work completed _____ 19

Remarks: