

Name Custom-Built Homes

Service No. 108 3223

Address 22 Munroe Road

Lexington, Mass.

Location 22 Munroe Road

Kind of Pipe

Size

Size of Main

~~Repair - Broadway~~ New Service

Com. 12-16-46

Location

Date	Material	Amount	Total	Date	Amount
Nov. 30, '46	Labor	19 44	19 44	Nov. 25 '46	40 00
	10% Overhead		1 94	Dec 31 '46	6 24
	36' - $\frac{3}{4}$ " Copper Tubing @.23		8 28		33 26
	1 - $\frac{3}{4}$ " C x $\frac{1}{2}$ " I.W.H. S & W		2 82	Nov. 30. '46	14 04
	1 - $\frac{3}{4}$ " C x $\frac{3}{4}$ " C Union (2 parts)		78	26(- $\frac{3}{4}$ " Copper Tubing @.23	5 98
			33 26	1 - $\frac{3}{4}$ " C Corp-cock	2 70
				1 - $\frac{3}{4}$ " C x $\frac{3}{4}$ " C Curb-cock	3 30
				1 - $\frac{3}{4}$ " C x $\frac{3}{4}$ " C Union (2 parts)	78
				1 - Box & Rod	3 30
				1 - $\frac{1}{2}$ " Offset Tail Piece	50
				1 - $\frac{1}{2}$ " Straight Tail Piece	50
					31 10
	Labor				

Deposited
Refunded
Non-Charge

TOWN OF LEXINGTON — BOARD OF PUBLIC WORKS

WATER DIVISION

The undersigned applies for a supply of water at No. _____ St. and hereby agrees to comply with the rules and regulations as now, or at any future time, established by the Board of Selectmen.


Am't. of Estimate \$ _____

Owner _____

Am't. Paid \$ _____

Address _____

Builder _____

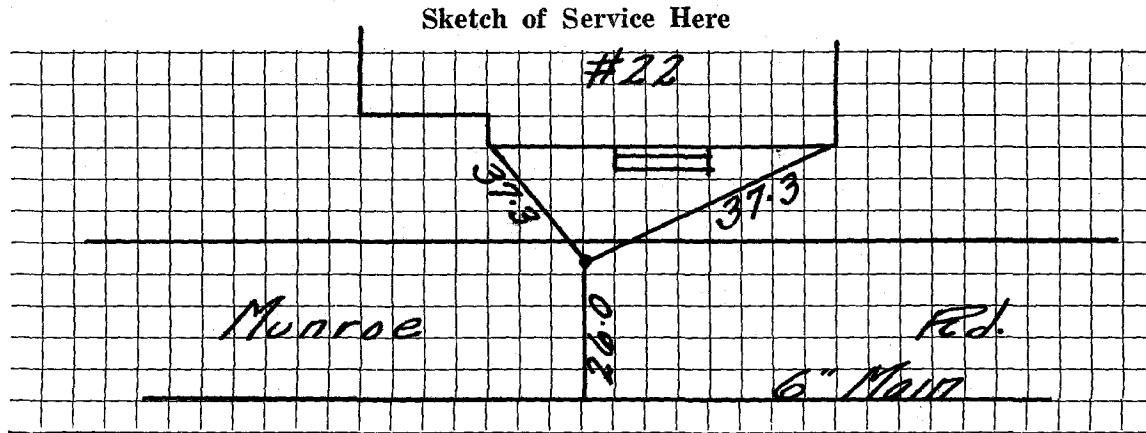

Connection made in _____ Street.

Work completed _____ 19

Remarks: