

Name Custom-Built Homes

Service No. 1083218

Address 25 Munroe Road

5896

Lexington, Mass.

Location 25 Munroe Road

Kind of Pipe

Size

Size of Main

~~Repair-Renewal~~ - New Service

Com. 12-16-46

Location

Date	Material	Amount	Total	Date	Location	Amount
Nov. 30, '46	Labor	19 98	19 98	Nov. 25 '46	Deposited	40 00
	10% Overhead		2 00	Dec 31 '46	Refunded	6 69
	37' - $\frac{3}{4}$ " Copper Tubing @.23		8 51		Non-Charge	33 31
	1 - $\frac{3}{4}$ " C x $\frac{1}{2}$ " I.W.H. Stop & Waste	2 82	33 31	Nov. 30, '46	Labor	7 56
					14' - $\frac{3}{4}$ " Copper Tubing @.23	3 22
					1 - $\frac{3}{4}$ " C Corp-cock	2 70
					1 - $\frac{3}{4}$ " C x $\frac{3}{4}$ " C Curb-cock	3 30
					1 - Box & Rod	3 30
					1 - $\frac{3}{4}$ " C x $\frac{3}{4}$ " C Union (2 parts)	78
					1 - $\frac{1}{2}$ " Straight Tail Piece	50
					1 - $\frac{1}{2}$ " Offset Tail Piece	50
						<u>21 86</u>
	Labor					

Hadley Press, Inc., Lexington

DATE _____

TOWN OF LEXINGTON—BOARD OF PUBLIC WORKS

WATER DIVISION

The undersigned applies for a supply of water at No. _____ St. and hereby agrees to comply with the rules and regulations as now, or at any future time, established by the Board of Selectmen.

Am't. of Estimate \$ _____


Owner _____

Am't. Paid \$ _____

Address _____

Builder _____

Sketch of Service Here

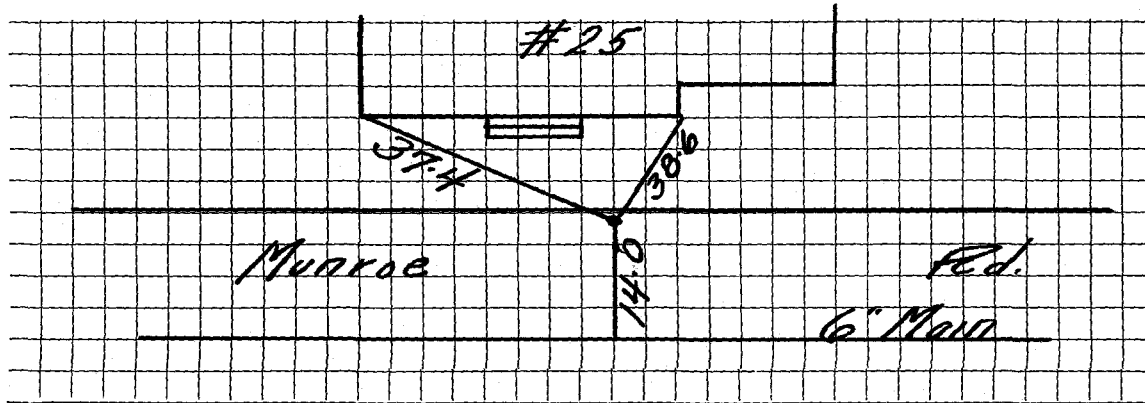

Connection made in _____ Street.

Work completed _____ 19

Remarks: