

Name Custom-Built Homes

Service No. 108-3219

Address 29 Munroe Road

3477

Lexington, Mass.

Location 29 Munroe Road

Kind of Pipe

Size

Size of Main

~~Repair/Removal~~—New Service

Com. 12-16-46

Location

Date	Material	Amount	Total	Date	Location	Amount
Nov. 30, '46	Labor	21 60	21 60	Nov. 25 '46	Deposited	40 00
	10% Overhead		2 16	Dec 31 '46	Refunded	40 00
	40' - 3/4" Copper Tubing @.23	9 20	9 20		Non-Charge	33 78
	1 - 3/4" C x 1/2" I.W.H. S.& W.	2 82	2 82	Nov. 30, '46	Labor	9 18
			35 78	17' - 3/4" Copper Tubing @.23		3 91
				1 - 3/4" C Corp-cock		2 70
				1 - 3/4" C x 3/4" C Curb-cock		3 30
				1 - 3/4" C x 3/4" C Union (2 parts)		78
				1 - Box & Rod		3 30
				1 - 1/2" Straight Tail Piece		50
				1 - 1/2" Offset Tail Piece		50
						<u>24 17</u>
	Labor					

Hadley Press, Inc., Lexington

TOWN OF LEXINGTON—BOARD OF PUBLIC WORKS

WATER DIVISION

The undersigned applies for a supply of water at No. _____ St. and hereby agrees to comply with the rules and regulations as now, or at any future time, established by the Board of Selectmen.


Am't. of Estimate \$ _____

Owner _____

Am't. Paid \$ _____

Address _____

Builder _____

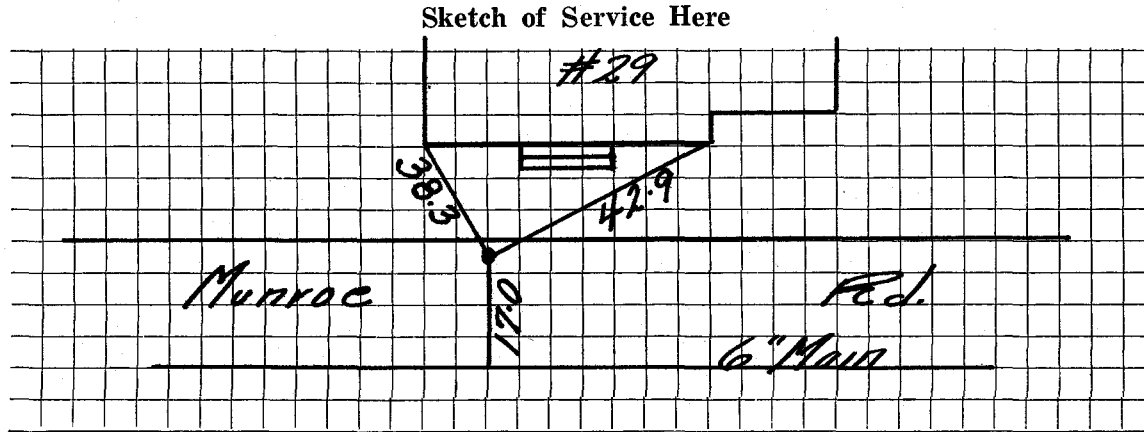

Connection made in _____ Street.

Work completed _____ 19

Remarks: