

Name Custom Built Homes

Service No. 108 3221

Address 30 Munroe Road

Lexington, Mass.

Location 30 Munroe Road

Kind of Pipe

Size

Size of Main

~~Repair-Renewal~~ New Service

Com 12-16-46

Location

Date	Material	Amount	Total	Date	Amount
Nov. 30, '46	Labor	20 52	20 52	Nov. 25 '46	40 00
	10% Overhead		2 05	Dec 31 '46	6 87
	38' - $\frac{3}{4}$ " Copper Tubing @.23		8 74		34 13
	1 - $\frac{3}{4}$ " C x $\frac{1}{2}$ " I.W.H. S & W		2 82	Nov. 30, '46 Labor	17 28
			34 13	32' - $\frac{3}{4}$ " Copper Tubing @.23	7 36
				1 - $\frac{3}{4}$ " C Corp-cock	2 70
				1 - $\frac{3}{4}$ " C x $\frac{3}{4}$ " C Curb-cock	3 30
				1 - $\frac{3}{4}$ " C x $\frac{3}{4}$ " C Union (2 parts)	78
				1 - Box & Rod	3 30
				1 - $\frac{1}{2}$ " Straight Tail Piece	50
				1 - $\frac{1}{2}$ " Offset Tail Piece	50
					35.72
	Labor				

DATE _____

TOWN OF LEXINGTON—BOARD OF PUBLIC WORKS

WATER DIVISION

The undersigned applies for a supply of water at No. _____ St. and hereby agrees to comply with the rules and regulations as now, or at any future time, established by the Board of Selectmen.

Am't. of Estimate \$ _____


Owner _____

Am't. Paid \$ _____

Address _____

Builder _____

Sketch of Service Here

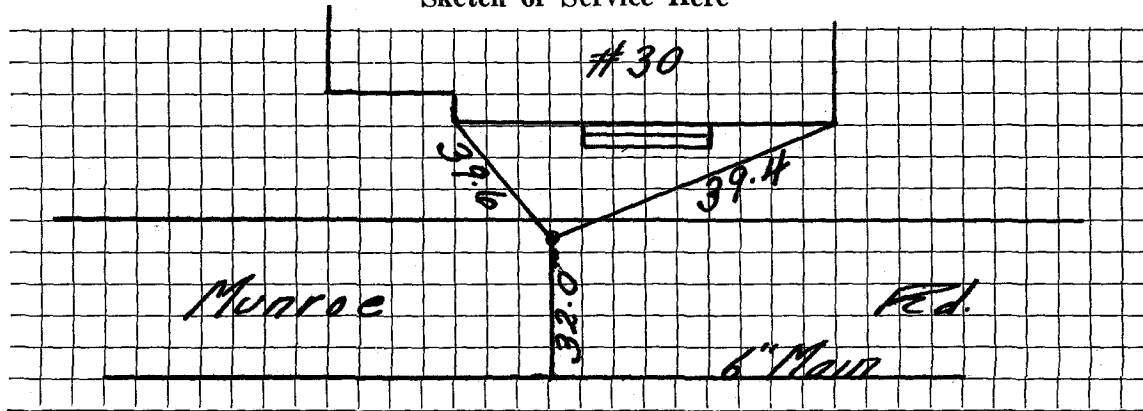

Connection made in _____ Street.

Work completed _____ 19

Remarks: