

Name Custom Built Homes

Service No. 108 3213

Address 37 Munroe Road

2944

Lexington, Mass.

Location 37 Munroe Road

#4069

Kind of Pipe

Size

Size of Main

~~Repairs-Renewals~~ - New Service

Com. 12.16.46

Location

Date	Material	Amount	Total	Date	Amount
Nov. 30, '46	Labor	21 60	21 60	Nov. 25 '46	40 00
	10% Overhead		2 16	Dec. 31 '46	4 22
	40' - $\frac{3}{4}$ " Copper Tubing @.23		9 20		35 78
	1 - $\frac{3}{4}$ " C x $\frac{1}{2}$ " I.W.H. S & W.		2 82	Nov. 30, '46	Labor
			35 78	14' - $\frac{3}{4}$ " Copper Tubing @.23	3 22
				1 - $\frac{3}{4}$ " C Corp-cock	2 70
				1 - $\frac{3}{4}$ " C x $\frac{3}{4}$ " C Curb-cock	3 30
				1 - $\frac{3}{4}$ " C x $\frac{3}{4}$ " C Union 2 parts	78
				1 - Box & Rod	3 30
				1 - $\frac{1}{2}$ " Straight Tail Piece	50
				1 - $\frac{1}{2}$ " Offset Tail Piece	50
					21 86
	Labor				

Deposited  
Refunded  
Non-Charge

Hadley Press, Inc., Lexington

DATE \_\_\_\_\_

# TOWN OF LEXINGTON—BOARD OF PUBLIC WORKS

## WATER DIVISION

The undersigned applies for a supply of water at No. \_\_\_\_\_ St. and hereby agrees to comply with the rules and regulations as now, or at any future time, established by the Board of Selectmen.

Am't. of Estimate \$ \_\_\_\_\_


Owner \_\_\_\_\_

Am't. Paid \$ \_\_\_\_\_

Address \_\_\_\_\_

Builder \_\_\_\_\_

Sketch of Service Here

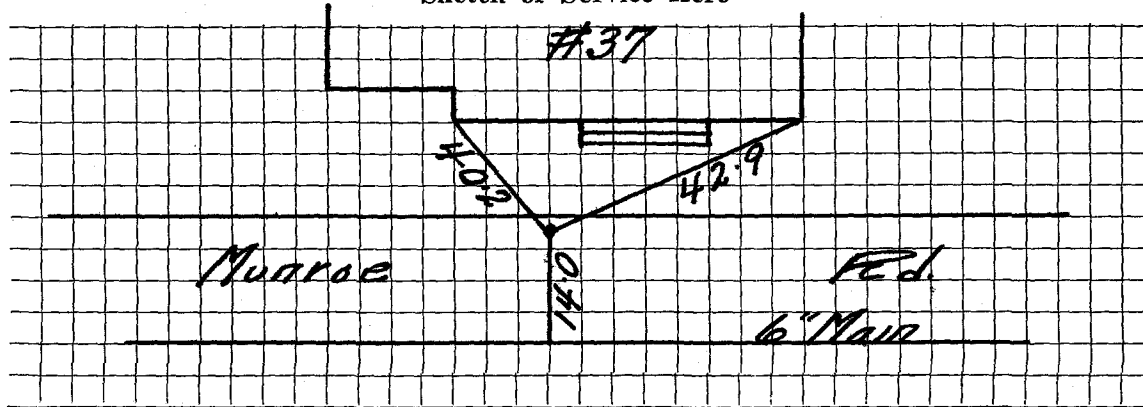

Connection made in \_\_\_\_\_ Street.

Work completed \_\_\_\_\_ 19

Remarks: