

Name Custom Built Homes

Service No. 108 3217

Address 41 Munroe Road

#5763

Lexington, Mass.

Location 41 Munroe Road

Kind of Pipe

Size

Size of Main

~~Repair - Renewal~~ - New Service

Com. 12-16-46

Location

Date	Material	Amount	Total	Date	Location	Amount
Nov. 30, '46	Labor	21 60	21 60	Nov. 25 '46	Deposited	40 00
	10% Overhead		2 16	Dec 31 '46	Refunded	3 44
	40' - 3/4" Copper Tubing @.23		9 20		Non-Charge	36 56
	1 - 3/4" C x 1/2" I.W.H. Stop & Waste	2 82		Nov. 30, '46	Labor	7 56
	1 - 3/4" C x 3/4" C Union (2 parts)	78	36 56	14' - 3/4" Copper Tubing @.23		3 22
				1 - 3/4" C Corp-cock		2 70
				1 - 3/4" C x 3/4" C Curb-cock		3 30
				1 - Box & Rod		3 30
				1 - 1/2" Straight Tail Piece		50
				1 - 1/2" Offset Tail Piece		50
						<u>21 08</u>
	Labor					

Hadley Press, Inc., Lexington

DATE _____

TOWN OF LEXINGTON — BOARD OF PUBLIC WORKS

WATER DIVISION

The undersigned applies for a supply of water at No. _____ St. and hereby agrees to comply with the rules and regulations as now, or at any future time, established by the Board of Selectmen.

Am't. of Estimate \$ _____


Owner _____

Am't. Paid \$ _____

Address _____

Builder _____

Sketch of Service Here

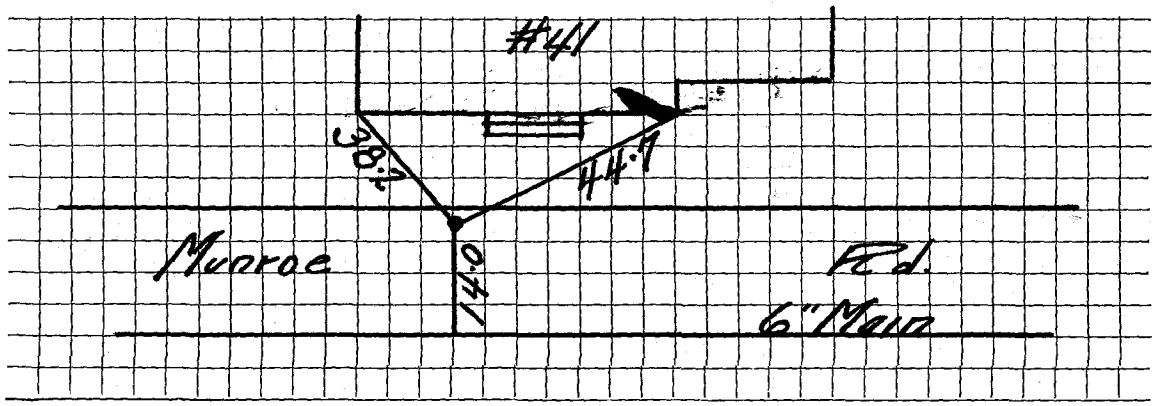

Connection made in _____ Street.

Work completed _____ 19

Remarks: