

Name Custom Built Homes

Service No. 108 3214

Address 45 Munroe Road

Lexington, Mass.

Location 45 Munroe Road

Kind of Pipe

Size

Size of Main

~~Repair - Renewal~~ New Service

Com 12.16.46

Location

Date	Material	Amount	Total	Date	Location	Amount
Nov. 30, '46	Labor	20 52	20 52	Nov 25 '46	Deposited	40 00
	10% Overhead		2 05	Dec 31 '46	Refunded	5 87
	38' - $\frac{3}{4}$ " Copper Tubing @ .23		8 74		Non-Charge	34 13
	1 - $\frac{3}{4}$ " C x $\frac{1}{2}$ " I.W.H. S & W		2 82	Nov. 30, '46	Labor	8 64
			34 13	16' - $\frac{3}{4}$ " Copper Tubing @ .23		3 68
				1 - $\frac{3}{4}$ " C Corp-cock		2 70
				1 - $\frac{3}{4}$ " C x $\frac{3}{4}$ " C Curb-cock		3 30
				1 - $\frac{3}{4}$ " C x $\frac{3}{4}$ " C Union (3 Parts)		1 32
				1- Box & Rod		3 30
				1 - $\frac{1}{2}$ " Straight Tail Piece		50
				1 - $\frac{1}{2}$ " Offset Tail Piece		50
						23 94
	Labor					

DATE _____

TOWN OF LEXINGTON—BOARD OF PUBLIC WORKS

WATER DIVISION

The undersigned applies for a supply of water at No. _____ St. and hereby agrees to comply with the rules and regulations as now, or at any future time, established by the Board of Selectmen.

Am't. of Estimate \$ _____


Owner _____

Am't. Paid \$ _____

Address _____

Builder _____

Sketch of Service Here

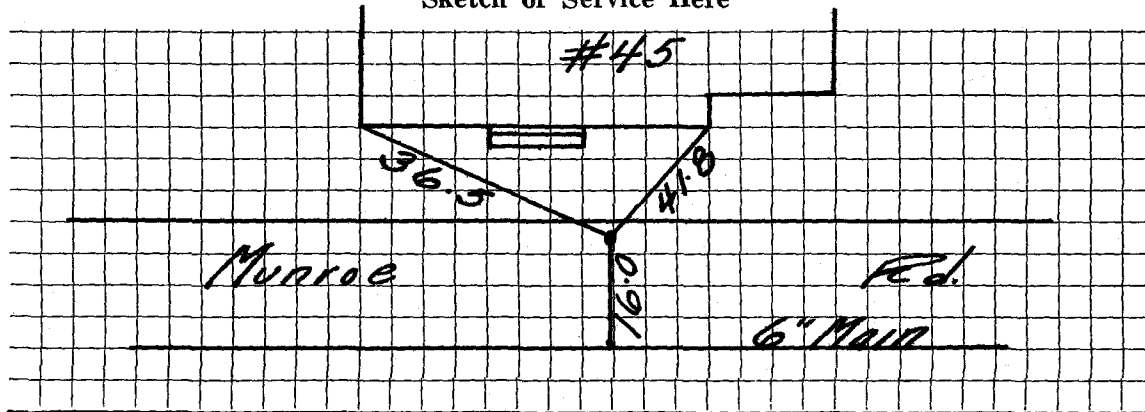

Connection made in _____ Street.

Work completed _____ 19

Remarks: