

WATER SERVICE RECORD

Name Eric Michelson

Service No.

Address 46 MUNROE ST.

Location

Repair Renewal - New Service McLaughlin #0357


Date	Material	Amount	Total	Date		Amount
7/22/94	43 LB 1" COPPER					
	1" CURB STOP					
	3/4" X 1" UNION			Nov. 30 '46'		
				26'	3/4" Copper	
					1 3/4" C. Corp Cock	
					1 3/4" C. X 3/4" C. Curb Cock	
					1 3/4" C. X 3/4" C. - 3 Part Union	
					1 Box + Rod	

DATE 7/22/94

TOWN OF LEXINGTON — BOARD OF PUBLIC WORKS

**WATER DIVISION**

Sketch of Service Here

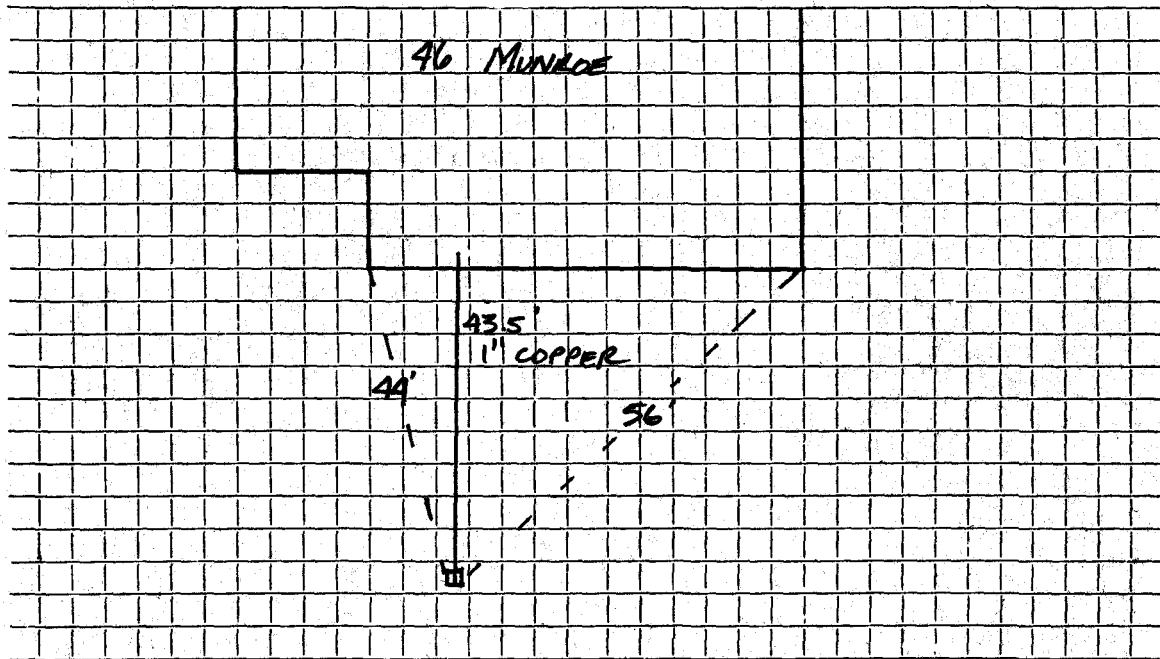

Connection made in ..... MUNROE ..... Street. Work completed .....

Remarks: .....  
.....  
.....