

Name Custom Built Homes

Service No.

72 3135  
8325

Address 49 Munroe Road

Lexington, Mass.

Location 49 Munroe Road

Kind of Pipe

Size

Size of Main

Repair—Renewal—New Service

Location

Date	Material	Amount	Total	Date	Amount
Aug. 14, '47	Labor	18 51		July 25 '47	Deposited 45 00
15	"	3 80		Sept 25 '47	Refunded 1 74
18	"	4 85	21 16		Non-Charge 43 20
	10% Overhead		2 12	Aug. 14, '47	-
	36' - 3/4" Copper Tubing @.28		10 08	18	Labor 35 97
	1 - 3/4" C x 1/2" I.W.H. S & W		3 15	13' - 3/4" Copper Tubing @.28	3 64
	Shovel 1 hr. @3.00		3 00	1 - 3/4" C Corp-cock	3 00
	Tractor 1 hr. @3.00		3 00	1 - 3/4" C x 3/4" C Curb-cock	3 68
	Trucking 1 hr. @.75		75	1 - Box & Rod	4 26
			43 26	Dynamite 7 lbs. @.21	1 47
				Exploders 2 @.105	63
				Compressor 4 hrs. @1.75	7 00
	Labor			1 - 1/2" Offset & Straight Tail Pieces	60
				Trucking 1 hr. @.75	75
					61 00

DATE \_\_\_\_\_

# TOWN OF LEXINGTON—BOARD OF PUBLIC WORKS

## WATER DIVISION

The undersigned applies for a supply of water at No. \_\_\_\_\_ St. and hereby agrees to comply with the rules and regulations as now, or at any future time, established by the Board of Selectmen.

Am't. of Estimate \$ \_\_\_\_\_


Owner \_\_\_\_\_

Am't. Paid \$ \_\_\_\_\_

Address \_\_\_\_\_

Builder \_\_\_\_\_

Sketch of Service Here

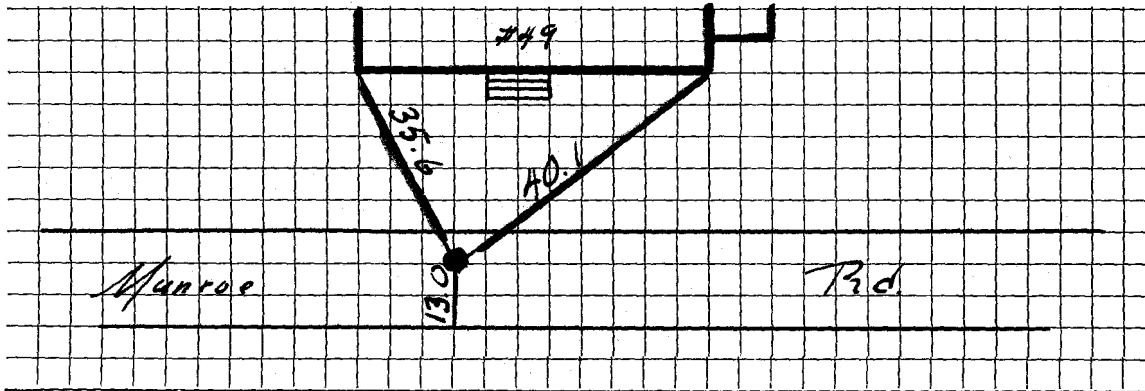

Connection made in \_\_\_\_\_ Street.

Work completed \_\_\_\_\_ 19

Remarks: