
			Water Service Record					
	Name						Service No.	
	Address 5	MUNROE RO	-					
er Joseph	Location Lexing Ton, MA							
	Repair - Renew	val - New Service						
	Date	Material	Amount	Total	Date		Amount	
	7/28/22	IN TYPE K COPPER			1			
							· <u>-</u> .	

	Date	Material	Amount	Total	Date		Amount
	7/28/22	1" Type K Copper					
		1" CURBSTOP		·		·	
		OPEN RIGHT				-	
	allah Trakanan S	BUFFALL BOX					
	(1)						
1			·				
					·		
ं ई इ.स. <u>.</u>							
				:			
							_

Date: 7/28/22

TOWN OF LEXINGTON - BOARD OF PUBLIC WORKS WATER DIVISON

SKETCH OF SERVICE HERE

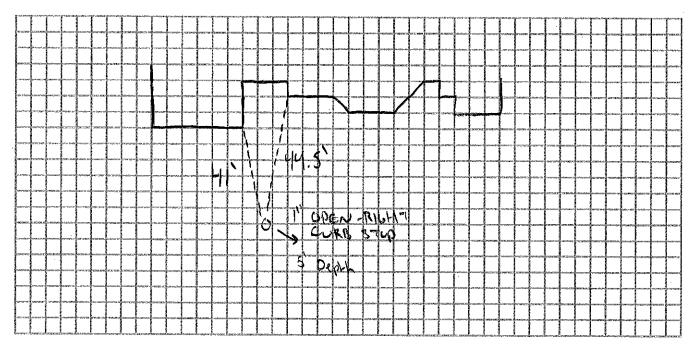

Connection made in:	Street.	Work completed:
Remarks: Installed By PERONI	CONSTRUCT	ION
нинвинининичениндения голопия пистичения поличения принциперации поличения п	**************************************	
учен в регуниции при при при при при при при при при п	f 1859 (1 1841 1 1841 1 1 1 1 1 1 1 1 1 1 1 1 1	тионичения плания, на при
омен в применя при	н Байлейн шин актипин шин актипин тараже	тининитингингиндинденденденденденденден органия ининининин ининининденденденденденденденденденденденденден