

Name Custom Built Homes

Service No. 3319

Address 50 Munroe Road

#6172

Lexington, Mas .

Location 50 Munroe Road

Kind of Pipe

Size

Size of Main

~~Repair~~ ~~Renewal~~ - New Service

Location

Date	Material	Amount	Total	Date	Amount
Aug. 15, '47	Labor	7 75		July 25 '47	45 00
18	"	1 05	8 80	Sept 25 '47	15 33
	10% Overhead		88		29 67
	34' - 3/4" Copper Tubing @.28		9 52	Aug. 15, '47-	
	1 - 3/4" C x 1/2" I.W.H. S & W		3 15	18 Labor	9 29
	1 - 3/4" C x 3/4" C Union (3 pts)		1 32	28' - 3/4" Copper Tubing @.28	7 84
	Shovel 1 hr. @3.00		3 00	1 - 3/4" C Corp-cock	3 00
	Tractor 1 hr. @3.00		3 00	1 - 3/4" C x 3/4" C Curb-cock	3 68
			29 67	1 - Box & Rod	4 26
				1 - 1/2" Straight Tail Piece	30
				1 - 1/2" Offset Tail Piece	30
				Shovel 1 hr. @3.00	3 00
	Labor			Tractor 1 hr. @3.00	3 00
				Trucking 1 hr. @.75	75
					35 42

Hadley Press, Inc., Lexington

DATE _____

TOWN OF LEXINGTON—BOARD OF PUBLIC WORKS

WATER DIVISION

The undersigned applies for a supply of water at No. _____ St. and hereby agrees to comply with the rules and regulations as now, or at any future time, established by the Board of Selectmen.

Am't. of Estimate \$ _____


Owner _____

Am't. Paid \$ _____

Address _____

Builder _____

Sketch of Service Here

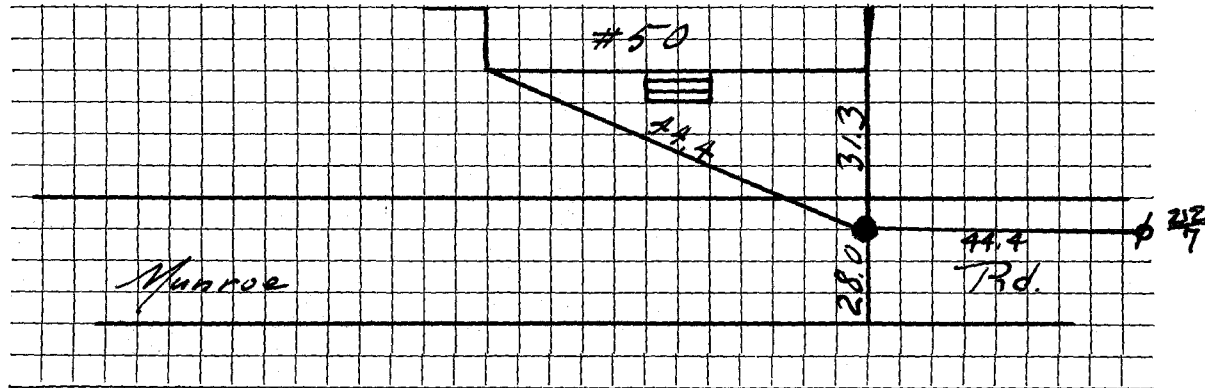

Connection made in _____ Street.

Work completed _____ 19

Remarks: