

Name Custom Built Homes

Service No. 72 8326

Address 54 Munroe Road

Lexington, Mass.

Location 54 Munroe Road

Kind of Pipe

Size

Size of Main

~~Renewal~~ - New Service

Location

Date	Material	Amount	Total	Date	Location	Amount
Aug. 15, '47	Labor	3 00	3 00	July 25 '47	Deposited	45 00
	10% Overhead		30	Sept 25 '47	Refunded	20 40
	36' - 3/4" Copper Tubing @.28	10 08	10 08		Non-Charge	24 60
	1 - 3/4" C x 1/2" I.W.H. S & W	3 15	3 15	Aug. 16, '47	Labor	2 53
	1 - 3/4" C x 3/4" C Union (3 pts)	1 32	1 32		28' - 3/4" Copper Tubing @.28	7 84
	Shovel 1 hr. @ 3.00	3 00	3 00		1 - 3/4" C Corp-cock	3 00
	Tractor 1 hr. @3.00	3 00	3 00		1 - 3/4" C x 3/4" C Curb-cock	3 68
	Trucking 1 hr. @.75	.75	75		Shovel 1 hr. @3.00	3 00
			24 60		Tractor 1 hr. @3.00	3 00
					1 - Box & Rod	4 26
					1 - 1/2" Offset & Straight Tail Piece	60
					Trucking 1 hr. @.75	75
	<b>Labor</b>					<b>28 66</b>

Hadley Press, Inc., Lexington

# TOWN OF LEXINGTON—BOARD OF PUBLIC WORKS

## WATER DIVISION

The undersigned applies for a supply of water at No. \_\_\_\_\_ St. and hereby agrees to comply with the rules and regulations as now, or at any future time, established by the Board of Selectmen.

Am't. of Estimate \$ \_\_\_\_\_


Owner \_\_\_\_\_

Am't. Paid \$ \_\_\_\_\_

Address \_\_\_\_\_

Builder \_\_\_\_\_

Sketch of Service Here

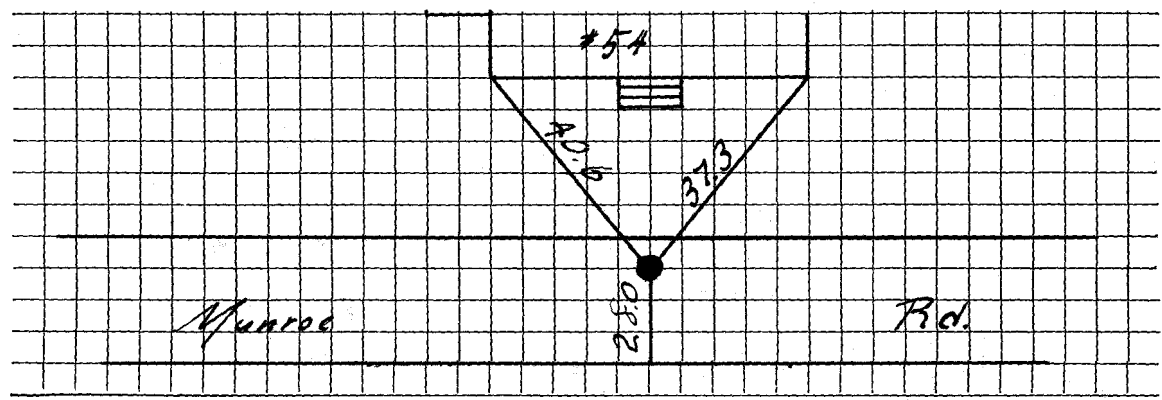

Connection made in \_\_\_\_\_ Street.

Work completed \_\_\_\_\_ 19

Remarks: