

Name Custom Built Homes

1227

Service No. 108 3227

Address 6 Munroe Road

Lexington, Mass.

Location 6 Munroe Road

Kind of Pipe

Size

Size of Main

~~Repair~~ ~~Renewal~~ - New Service

Com. 12-16-46

Location

| Date | Material | Amount | Total | Date | Amount |
|--------------|---|--------|-------|---|--------|
| Nov. 30, '46 | Labor | 17 82 | | Nov. 25 '46 | 40 00 |
| | 10% Overhead | 1 78 | 19 60 | Dec 31 '46 | 9 99 |
| | 33' - $\frac{3}{4}$ " Copper Tubing @.23 | | 7 59 | | 30 01 |
| | 1- $\frac{3}{4}$ " C x $\frac{1}{2}$ " I.W.H. S. & W. | | 2 82 | Nov. 30. '46 | 16 20 |
| | | | 30 01 | 30' - $\frac{3}{4}$ " Copper Tubing @.23 | 6 90 |
| | | | 1 | 1 - $\frac{3}{4}$ " C Corp-cock | 2 70 |
| | | | | 1 - $\frac{3}{4}$ " C x $\frac{3}{4}$ " C Curb-cock | 3 30 |
| | | | | 1 - Box & Rod | 3 30 |
| | | | | 1 - $\frac{1}{2}$ " Straight Tail Piece | 50 |
| | | | | 1 - $\frac{1}{2}$ " Offset Tail Piece | 50 |
| | | | | | 33 40 |
| | Labor | | | | |

Deposited
Refunded
Non-Charge

DATE _____

TOWN OF LEXINGTON—BOARD OF PUBLIC WORKS

WATER DIVISION

The undersigned applies for a supply of water at No. _____ St. and hereby agrees to comply with the rules and regulations as now, or at any future time, established by the Board of Selectmen.

Am't. of Estimate \$ _____


Owner _____

Am't. Paid \$ _____

Address _____

Builder _____

Sketch of Service Here

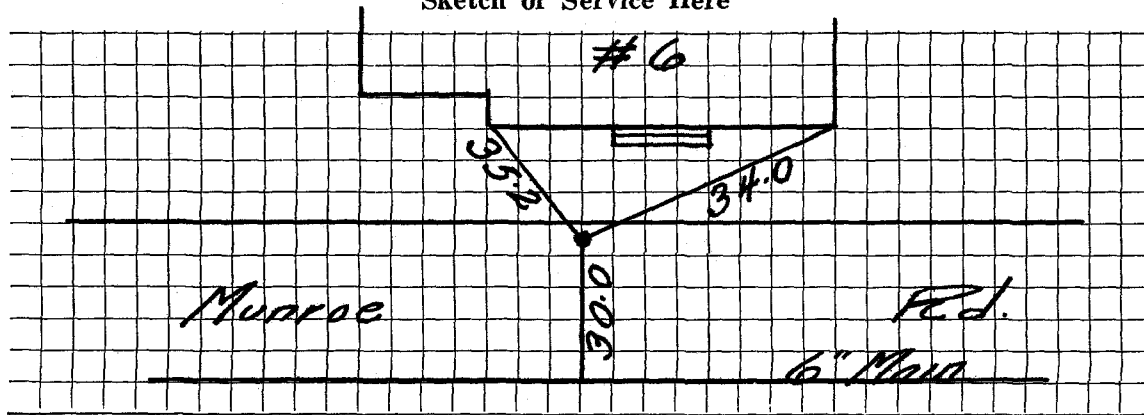

Connection made in _____ Street.

Work completed _____ 19

Remarks: