

Address 66 Munroe Road

Lexington, Mass.

Location 66 Munroe Road

Kind of Pipe

Size

Size of Main

~~XXXXXXXXXX~~—New Service

Com. 6-14-49

Location

Date	Material	Amount	Total	Date	Amount
May 9, '49	Labor	4 00	4 00	Mar 30 '49	30 00
	10% Overhead		40		
	64' - 3/4" Copper Tubing @.27		17 28		
	1 - 3/4" C x 1/2" I.W.H. S&W		3 29		
	1 - 3/4" C x 3/4" C Union (3pts)		1 39		
	Trucking 1 hr. @.75		75		
			27 11		
				May 9, '49	4 05
				25' - 3/4" Copper Tubing @.27	6 75
				1 - 3/4" C Corp-cock	3 15
				1 - 3/4" C x 3/4" C Gurb-cock	3 85
				1 - Box & Rod	3 85
				1 - 1/2" Straight Tail Piece	37
				1 - 1/2" Offset Tail Piece	37
				Littlefield Shovel 1 hr. @ 7.00	7 00
				Trucking 1 hr. @.75	75
	Labor				30 24

Deposited

Non-Charge

DATE _____

TOWN OF LEXINGTON – BOARD OF PUBLIC WORKS
WATER DIVISION

The undersigned applies for a supply of water at No..... St. and hereby agrees to comply with the rules and regulations as now, or at any future time, established by the Board of Selectmen.

Am't of Estimate \$.....

Owner


Am't Paid \$.....

Address

Builder

.....

Sketch of Service Here

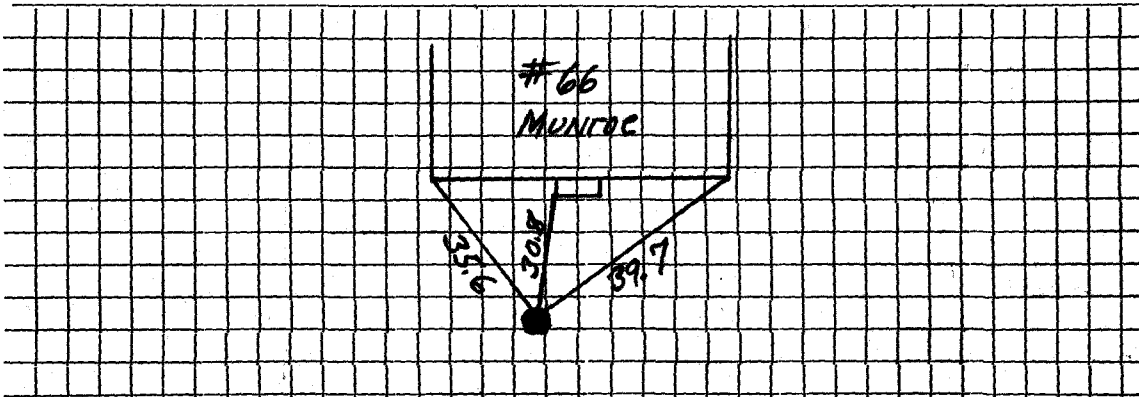

Connection made in Street.

Work completed19

Remarks: