

WATER SERVICE RECORD

Name

Service No.

Address

Location 9 MUNROE RD

Repair- Renewal New Service REDMOND


Date	Material	Amount	Total	Date	Amount
2/3/99	41' 1" COPPER			11/30/46	
	3/4 X 1" Comp				20' 3/4 COPPER
	1" VALVE				1 3/4 CURB STOP
	1 Buffalo Box				1 3/4 COPP

DATE _____

TOWN OF LEXINGTON — BOARD OF PUBLIC WORKS

WATER DIVISION

Sketch of Service Here

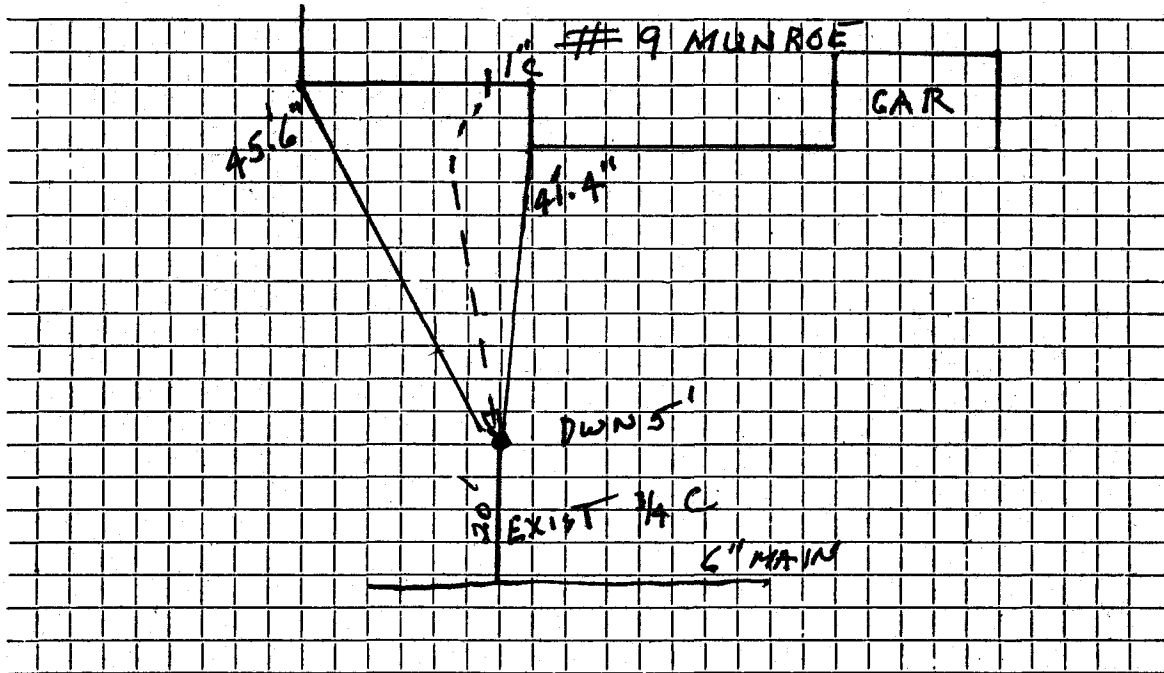

Connection made in Street. Work completed

Remarks:

.....

.....