




TOWN OF LEXINGTON — BOARD OF PUBLIC WORKS

WATER DIVISION

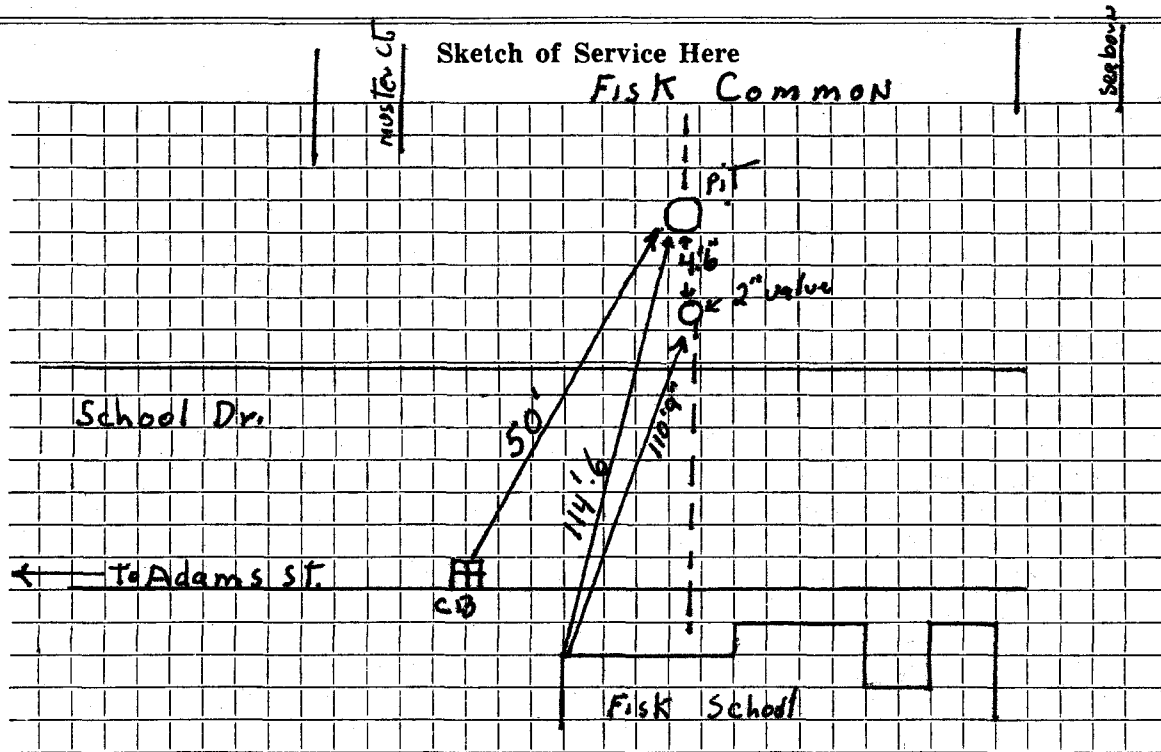

Connection made in School yd ..... Street.      Work completed .....

Remarks: 2" T9P .....

.....  
.....