

## WATER SERVICE RECORD

Name George Smith

Service No. 330

Address 10 Muzzey Street

Location

~~REPAIR~~—New Service

Conn. 12-19-55


Date	Material	Amount	Total	Date	Amount
11/3/55	Labor	8 54		10-6-55 Deposited	100 00
	10% Overhead	85	9 39	12-19-55 Paid	9 46
	140' - 1" Copper tubing @ .645		90 30		109 46
	1 - 1" Cx3/4" T.W.H. Stop & Waste		4 50	Labor 55	1 85
	2 - 1" Unions (3 part) @ 2.26		4 52	25' - 1" Copper Tubing @ .645	16 12
	1 hr. Trucking		75	1 - 1" C. Corp Cock	6 80
			109 46	1 - 1" C. Curb Cock	5 61
				1 Box & Rod	3 90
				1 3/4" Straight tail piece	50
				1 3/4" Offset tail piece	50
1/25/73	Instll service?		100 00		35 28

DATE \_\_\_\_\_

TOWN OF LEXINGTON — BOARD OF PUBLIC WORKS

WATER DIVISION

Sketch of Service Here  
10 MUZZY ST

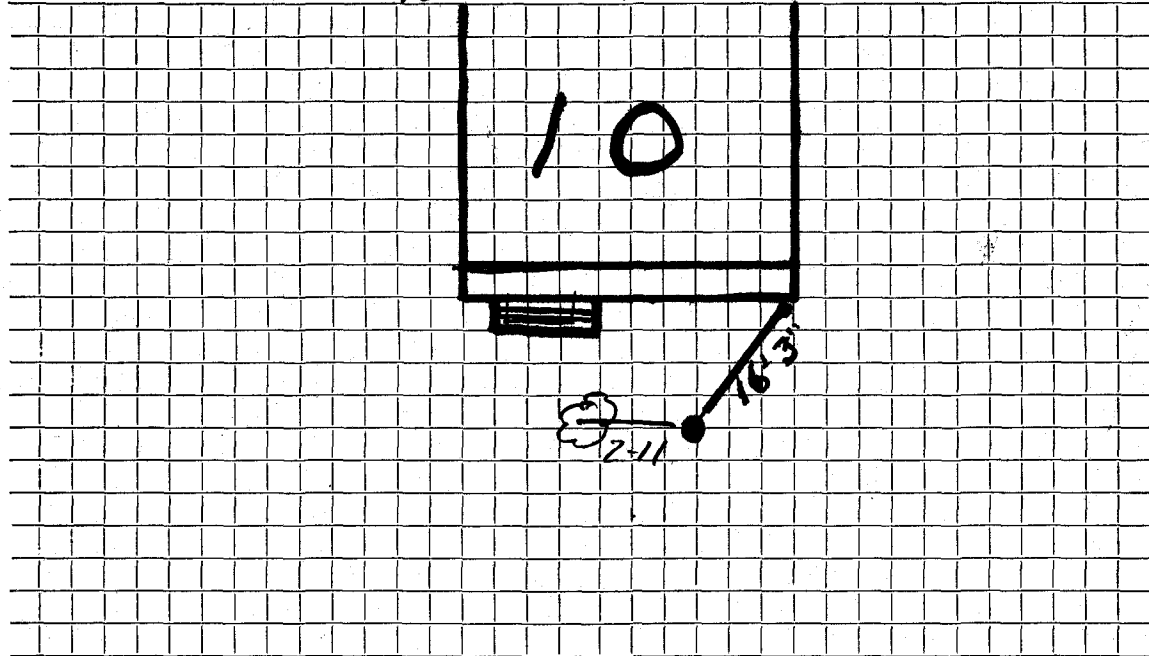

Connection made in ..... Street. Work completed .....

Remarks: .....

.....

.....