

WATER SERVICE RECORD

Name F. K. Johnson

Service No. 1

Address 11<sup>+13</sup> Muzzey Street

Location Lexington, Mass.

~~Renewal~~ - ~~NEW SERVICE~~


COM. 1-7-52

Date	Material	Amount	Total	Date	Amount
1/2/52	Labor	20 00			
	10% overhead	2 00	22 00	1-24-52	<i>No deposit Paid</i> 37 18
	32' - 3/4" copper tubing @ .326		10 43		
	1 - 3/4" C x 1/2 I.W.H. S&W		4 00		<u>No Charge</u>
	1 hr. trucking		75	1/2/52	13' -3/4" copper tubing @ .326 4 24
			37 18		Labor 29 45
					1 -3/4" C. corp-cock 4 33
					1 - 3/4" C x 3/4" C. curb-cock 4 67
					1 - box and rod 4 68
					1 - 1/2 offset tail piece 50
					1 - 1/2 straight tail piece 50
					3 hrs. #36 comp. @ 2.75 8 25
					1 hr. trucking 75
					patching 9 x 3 9 00
					<u>66 37</u>

DATE \_\_\_\_\_

**TOWN OF LEXINGTON — BOARD OF PUBLIC WORKS**  
**WATER DIVISION**

Sketch of Service Here

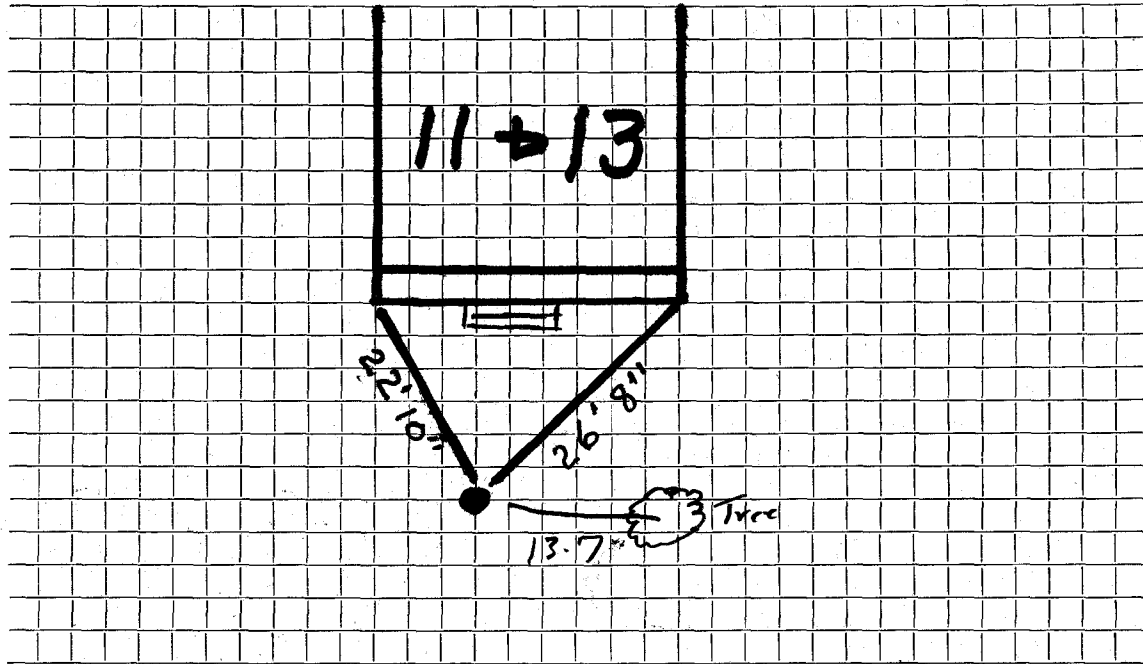

Connection made in ..... Street. Work completed .....

Remarks : .....  
.....  
.....