

Name Clifford G. Hunt

Service No. 228

Address 14 Muzzey Street

Lexington, Mass.

Location 14 Muzzey Street

Kind of Pipe

Size

Size of Main

~~RKPKK~~ Renewal ~~NKYKSKWEX~~

Com. 12-31-49

Location

| Date         | Material                    | Amount | Total | Date         | Amount                           |
|--------------|-----------------------------|--------|-------|--------------|----------------------------------|
| Oct. 29, '49 | Labor                       | 10 00  | 10 00 | Oct 21, 49   | Deposited 25 00                  |
|              | 10% Overhead                |        | 1 00  | Nov 1, 49    | Deposited 4 24                   |
|              | 19' - 1" Copper Tubing @.28 |        | 5 32  |              | No Charge 20 76                  |
|              | 1 - 1"C x 1" I.W.H. S&W     |        | 3 29  | Oct. 29, '49 | Labor 46 10                      |
|              | 1 - 1" x 3/4" Bushing       |        | 40    |              | 12' - 1" Copper Tubing @.28 3 36 |
|              | Trucking 1 hr. @.75         |        | 75    |              | 1 - 1"C Corp=cock 4 62           |
|              |                             |        | 20 76 |              | 1 - 1"C x 1"CCurb-cock 5 60      |
|              |                             |        |       |              | 1 - Box & Rod 3 75               |
|              |                             |        |       |              | 1 - 3/4" Offset Tail Piece 37    |
|              |                             |        |       |              | Trucking 1 hr. @.75 75           |
|              |                             |        |       |              | Patching 8 x 3 8 00              |
|              |                             |        |       |              | <u>72 55</u>                     |
|              | Labor                       |        |       |              |                                  |

DATE \_\_\_\_\_

# TOWN OF LEXINGTON – BOARD OF PUBLIC WORKS

## WATER DIVISION


The undersigned applies for a supply of water at No..... St. and hereby agrees to comply with the rules and regulations as now, or at any future time, established by the Board of Selectmen.

Am't of Estimate \$..... Owner .....

Am't Paid \$..... Address .....

Builder .....

Sketch of Service Here

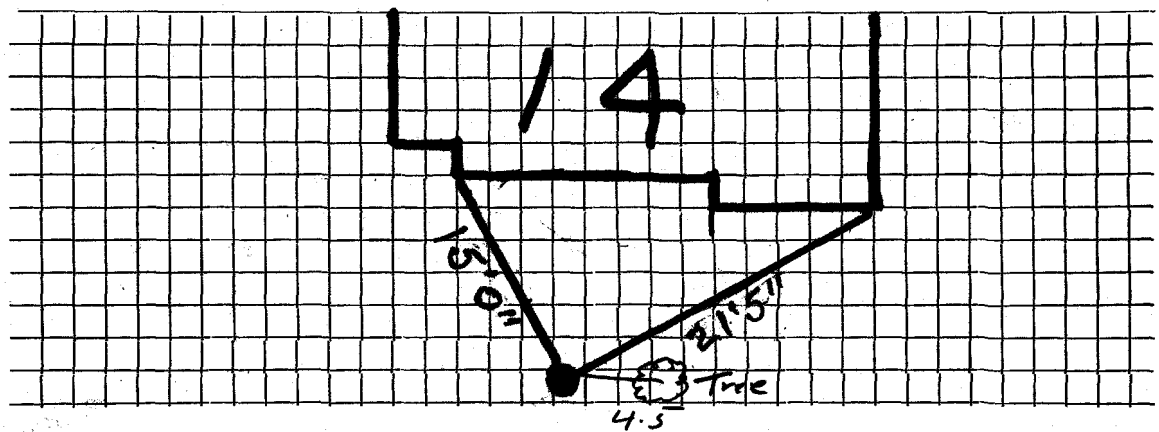

Connection made in ..... Street. Work completed .....19

Remarks: