

Name James J. Carroll

Service No. # 2016

Address 15/17 Muzzey St.

#217

Location

Kind of Pipe

Size

Size of Main

~~Repair - Renewal - New Service~~

Location

| Date | Material | Amount | Total | Date | Amount |
|---------|-------------------------|--------|---------|---------------------|--------|
| 6-21-32 | 26' 1" Copper Pipe @.26 | 6 76 | | June 30 1932 - Cash | 30 73 |
| | 1 1" "xl" I. Bend | 1 45 | | | |
| | 1 1" Br. S. Nipple | 25 | | | |
| | 1 S & W | 3 00 | | | |
| | Trucking | 75 | \$12 21 | | |
| | | | | | |
| 6/10/32 | 26 Hrs. Labor @.55 | 14 30 | | | |
| | 3 " " @.60 | 1 80 | 16 10 | | |
| | 15% Overhead | | 2 42 | | |
| | | | 30 73 | | |

Labor

Hidley Press, Inc., Lexington

DATE June 9, 1932

TOWN OF LEXINGTON—BOARD OF PUBLIC WORKS

WATER DIVISION

The undersigned applies for a supply of water at No. Muzzey St. and hereby agrees to comply with the rules and regulations as now, or at any future time, established by the Board of Selectmen.

Am't. of Estimate \$ _____

Owner

James J. Carroll


Am't. Paid \$ _____

Address

15-17 Muzzey St.
Lexington, Mass

Builder _____

Sketch of Service Here

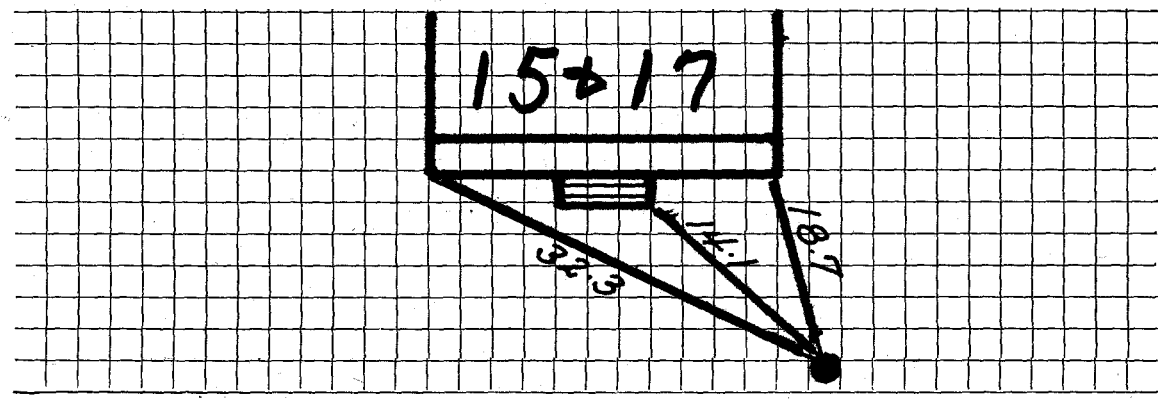

Connection made in _____ Street.

Work completed _____ 19

Remarks: