

Name Mildred Dacey

Service No. 155

Address 18 Muzzey Street

Location 18 Muzzey Street

Kind of Pipe

Size

Size of Main

~~Repair~~—Renewal—~~New Service~~

Com. 9-19019

Location

Date	Material	Amount	Total	Date	Amount
Aug. 2, '49	Labor	18 37	18 37	July 28, '49 Deposited	35 00
	10% Overhead		1 84	Sept 20 '49 Refunded	1 87
	37' - 3/4" Copper Tubing @.24		8 88	Non-Charge	83 13
	1 - 3/4" C x 1/2" I.W.H. S&W		3 29	Aug. 2, '49 Labor	43 00
	Trucking 1 hr.		75	20' - 3/4" Copper Tubing @.24	4 80
			33 13	1 - 3/4" C Corp-cock	3 15
				1 - 3/4" C x 3/4" C Curb-cock	3 85
				1 - Box & Rod	3 95
				1 - 1/2" Offset Tail Piece	37
				Compressor 1 hr.	1 75
				Trucking 1 hr.	75
				Patching 16 x 3	16 00
	Labor				77 62

TOWN OF LEXINGTON - BOARD OF PUBLIC WORKS
WATER DIVISION

The undersigned applies for a supply of water at No..... St. and hereby agrees to comply with the rules and regulations as now, or at any future time, established by the Board of Selectmen.

Am't of Estimate \$.....

Owner


Am't Paid \$.....

Address

Builder

.....

Sketch of Service Here

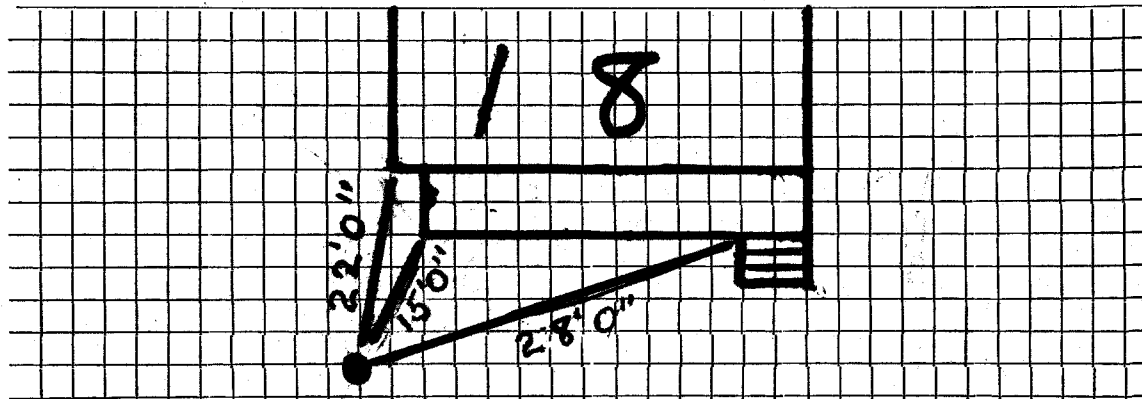

Connection made in Street.

Work completed19

Remarks: