

## WATER SERVICE RECORD

Name Sasso Construction

Service No. 52

Address 19 Muzzey Street

Location

Repair ~~Renewal~~ New Service

W.O. # 9129

APR 20 1971


Date	Material	Amount	Total	Date	Amount	
11/23/70	Labor		14 04	10-30-70	Deposit	325 00
	10% O.H.		1 40	4-20-71	Retard	38 64
20'	2" Copper pipe	2.00	40 00			186 36
12"	2" Service Saddle		16 30			
	2" Corporation		36 60			
	2" Curb Stop		54 02			
	Roadway gate box					
	Top bottom and cover		24 00			
			186 36			
8-31-71	10' 2" Copper tubing					

DATE \_\_\_\_\_

TOWN OF LEXINGTON — BOARD OF PUBLIC WORKS

**WATER DIVISION**

Sketch of Service Here

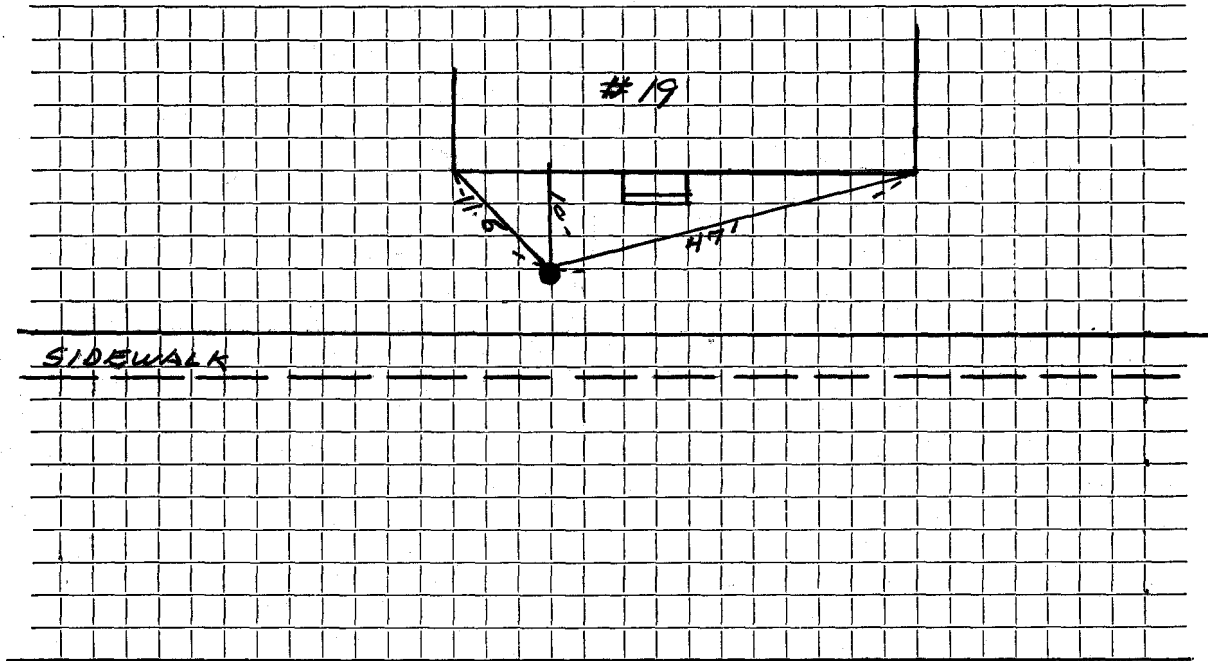

Connection made in ..... Street. Work completed .....

Remarks: *Original Service 10-14-46* .....

.....  
.....