

WATER SERVICE RECORD

Name Dennis J. Kelly

Service No. 325

Address 20 Muzzey Street

Location Lexington

~~Repair~~—Renewal—~~NEW SERVICE~~ Com. 12-29-52


Date	Material	Amount	Total	Date	Amount
12/4/52	Labor	20 22		12-1-52 Deposited	30 00
	10% Overhead	2 02	22 24	11-29-54 Cleared	37
	50'-1"C.Tubing @ .3997		19 99	NON-CHARGE	50 37
	1-1"CX1" IWH Stop & Waste		6 80	12/4/52 Labor	18.00
	1-1" X 3/4" Red.Bushing		59	12/5/52 Labor	41.48
	1 Hr. Trucking		75	24'-1"Copper Tubing @.3997	9 59
			50 37	1-1"C Curb-Cock	5 61
				1-1"C X 1"C Curb-Cock	6 80
				1 Box & Rod	3 90
				1 3/4" Straight Tail Piece	50
				1 3/4" Offset Tail Piece	50
				2 Hrs. Littlefield Shovel @7.00	14 00
				1 Hr. Trucking	75
				Patching 24 X 3	24 00
					125 13

bill sent 12-29-52

DATE _____

TOWN OF LEXINGTON — BOARD OF PUBLIC WORKS
WATER DIVISION

Sketch of Service Here
MUZZY ST

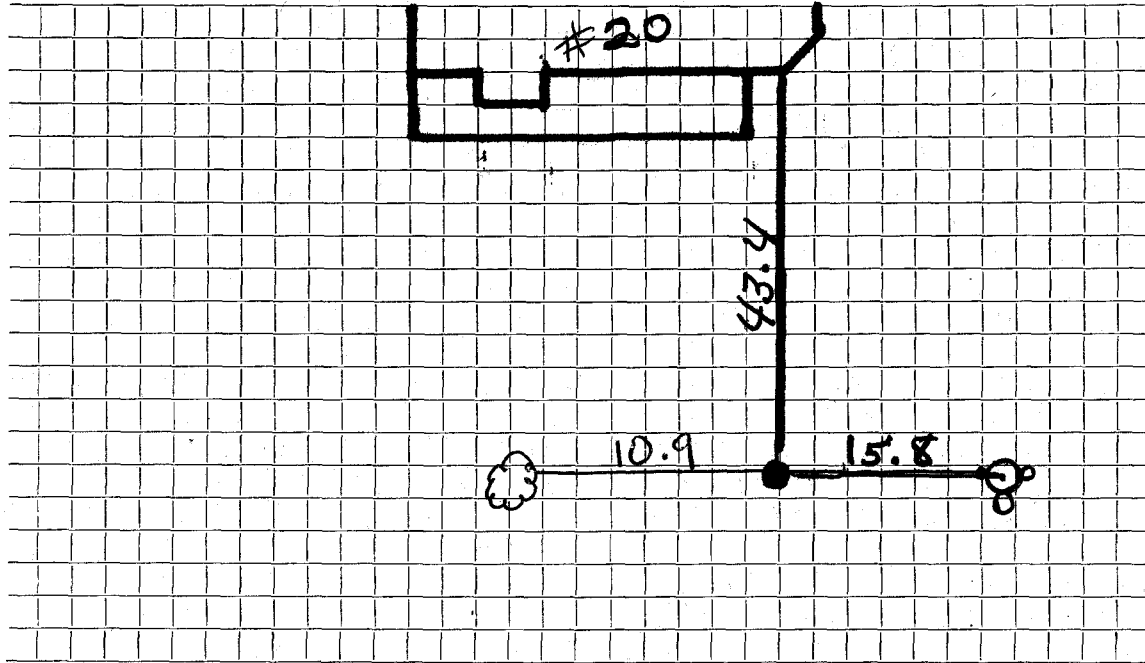

Connection made in Street. Work completed

Remarks:
.....
.....