

Name George H. Peterson

Service No. 2021

Address 21 Muzzey Street

Lexington 73, Mass.

Location

21 Muzzey Street

Kind of Pipe

Size

Size of Main

~~Repair—Renewal—New Service~~

Location

Date	Material	Amount	Total	Date	Amount
Mar. 5, '45	Labor	9 00		Mar. 5 '45	40 00
	"	<u>6 30</u>	15 30	Mar 22 '45	13 97
	10% Overhead		1 53		26 13
	24'-1" Copper Tubing @.22		5 28	Mar. 6, '45 Labor	6 30
	1-1" Cx1" I.W.H. Stop & Waste		2 65	7' - 1" Copper Tubing @.22	1 54
	1-1" x $\frac{3}{4}$ " Bushing		33	1 - 1" C. Corp.-cock	3 65
	1 - $\frac{3}{4}$ " x $\frac{1}{2}$ " Bushing		29	1 - 1" C x 1" C. Curb-cock	3 52
	Trucking 1 hr. @ .75		<u>75</u>	1 - Box & Rod	1 65
			26 13	Compressor 2 hrs. @ 1.75	3 50
				Trucking - 2 hrs. @.75	1 50
				Patching 7x3	4 66
					<u>26 32</u>
	Labor				

*Bill sent 3-13-45**Deposited
Refunded*

Non-Charge

TOWN OF LEXINGTON—BOARD OF PUBLIC WORKS

WATER DIVISION

The undersigned applies for a supply of water at No. _____ St. and hereby agrees to comply with the rules and regulations as now, or at any future time, established by the Board of Selectmen.

Am't. of Estimate \$ _____


Owner _____

Am't. Paid \$ _____

Address _____

Builder _____

Sketch of Service Here

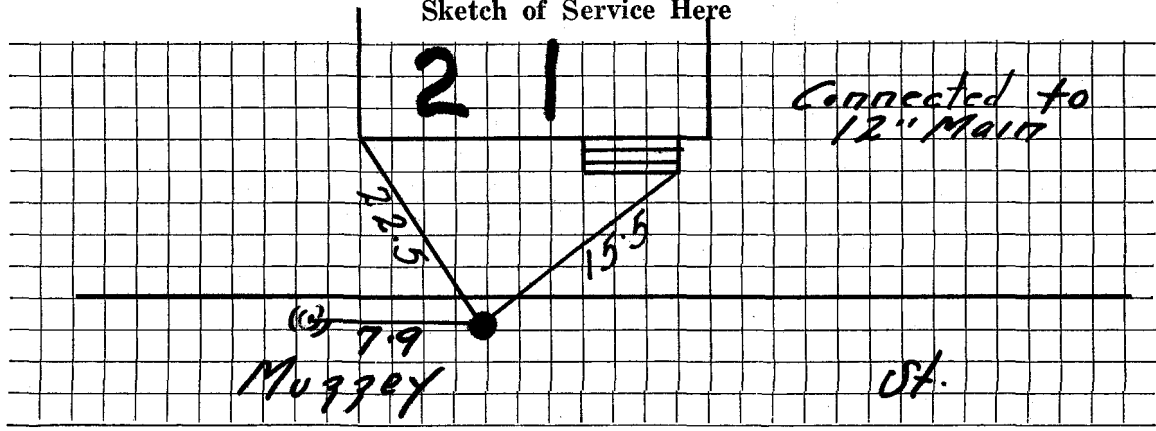

Connection made in _____ Street.

Work completed _____ 19

Remarks: