




DATE 7/18/95

TOWN OF LEXINGTON — BOARD OF PUBLIC WORKS

**WATER DIVISION**

Sketch of Service Here

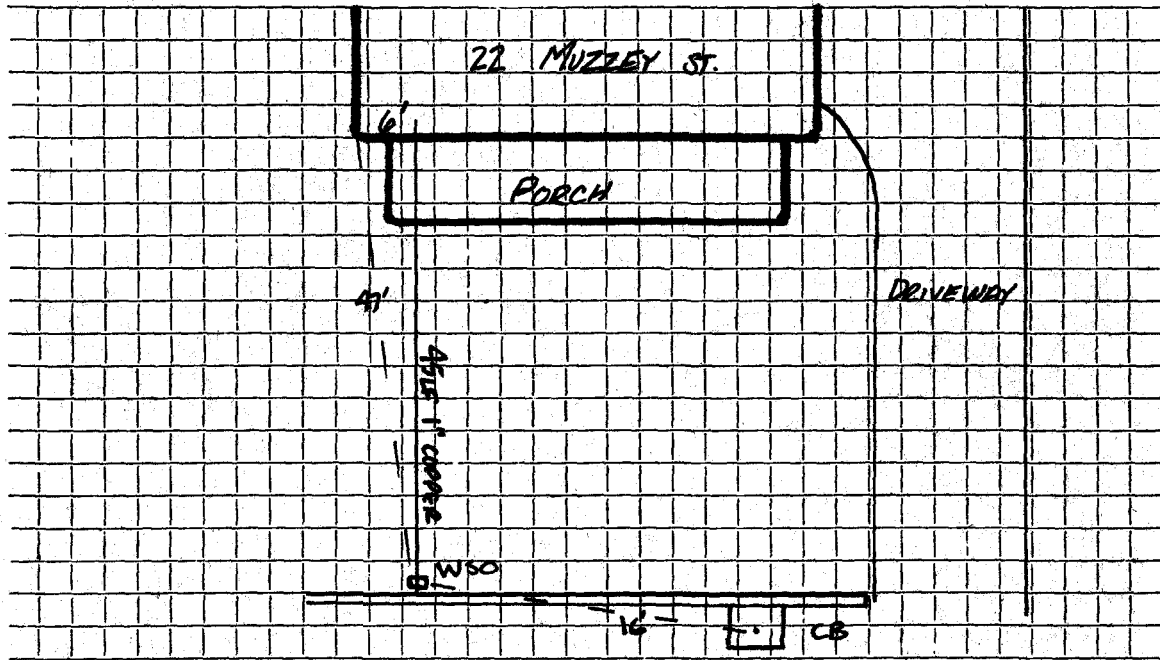

Connection made in MUZZEY Street. Work completed PAOUNI CORP.

Remarks: Original Service 7-13-27 - Outside service checked 7-20-94.  
3/4" Copper