

WATER SERVICE RECORD

Name W. P. Wright

Service No. 277

Address 26 Muzzey Street

Location

~~Repair~~ ~~Renewal~~ ~~New Service~~ Renewal

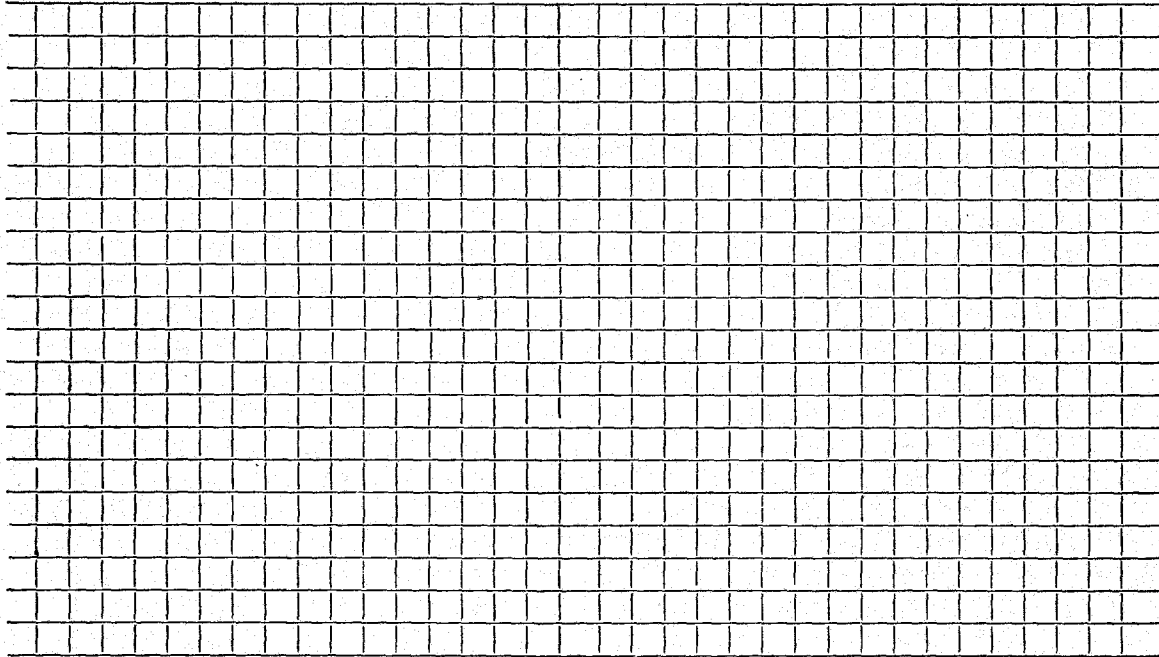
Comm. 12/31/57

Date	Material	Amount	Total	Date	Amount
12/3/57	Labor	33 73		11-27-57	Deposit \$ 1.7500
	10% overhead	3 37	37 10	12-31-57	Refund 25 98
	23' - 3/4" Copper tubing @ .37		8 51		\$ 44 62
	1 - 3/4" Brass Nipple		67		
	1 - 3/4" Union (2 part)		1 24		
	2 hrs. Trucking @ .75		1 50		
			<u>49 02</u>		

DATE \_\_\_\_\_

**TOWN OF LEXINGTON — BOARD OF PUBLIC WORKS**  
**WATER DIVISION**

Sketch of Service Here

A large grid of graph paper, consisting of 20 columns and 20 rows of small squares, intended for sketching service details.

Connection made in ..... Street.      Work completed .....

Remarks: .....  
.....  
.....