

Name New Eng. Tel &amp; Tel Co.

Service No. 10

2024

27  
Address Muzzy St.

Location

Muzzey Street

Kind of Pipe

Size

Size of Main

~~RENEWAL~~ Renewal ~~NEW~~ ~~XXXXX~~

Com 12/31/47

Location

Date	Material	Amount	Total	Date		Amount
4/25/47	Labor	19 78	19 78	4/17/47	Deposited	100 00
	10% Overhead		1 98	12/31/47	Refunded	2 37
	38' 2" C.L.Pipe @ .45		17 10			97 63
	30' 1" Copper Tubing @ .38		11 40			
	1 2" W.H. Gate Valve		6 40		Non-Charge	
	1 2" T.H. Gate Valve		9 75	4/24/47	Labor	12 03
	1 1"Cx2" I 4way Branch		9 55	4/25/47	Labor	29 62
	4 1" C.Corp.cock		15 84			41 65
	2 2" L.L.Elbows 90°		1 22			
	2 2" L.L.Elbows 45		1 22			
	2 2" C.L.Nipples 6"		52			
	2 2" C.L. Nipples 3"		37			
	Labor 1 2" L.L.Coupling		60			
	1 2" Close Nipple (Brass)		70			
	1 2"xl 1/2 Red.Cplg (Brass)		1 20			
			97 63			

TOWN OF LEXINGTON - BOARD OF PUBLIC WORKS

**WATER DIVISION**

The undersigned applies for a supply of water at No..... St. and hereby agrees to comply with the rules and regulations as now, or at any future time, established by the Board of Selectmen.

Am't of Estimate \$.....

Owner .....


Am't Paid \$.....

Address .....

Builder .....

*23 Marion St. Brookline - Mass.*

Sketch of Service Here

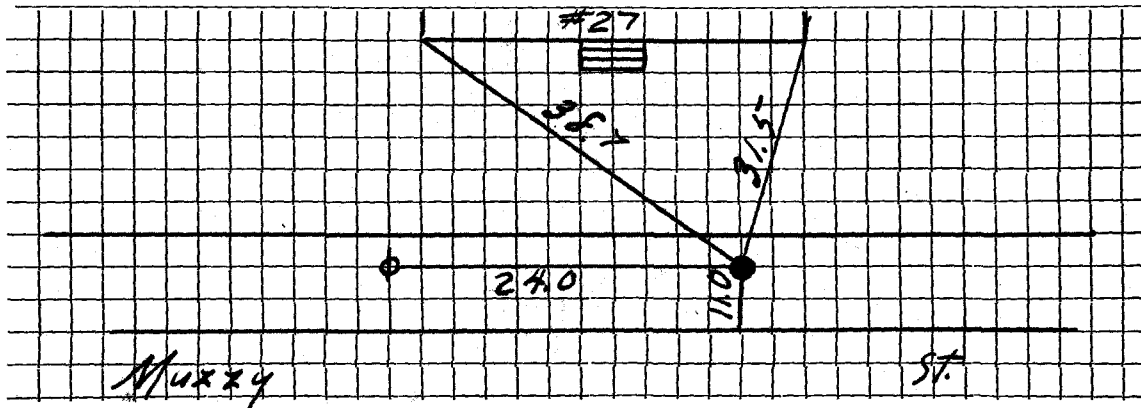

Connection made in ..... Street.

Work completed .....19

Remarks: