

## WATER SERVICE RECORD

Service No. 236

Name Mrs. C. Peterson

Address 28 Muzzey Street

#6847

Location

~~RENEW~~—Renewal—~~NEW SERVICE~~

Com. 12-19-55


Date	Material	Amount	Total	Date	Amount
7/21/55	Labor	8 97		7-20-55 Deposited	30 00
	10% Overhead	90	9 87	12-19-55 Returned	1 56
	36' 3/4" Copper Tubing @ .384		13 82	12-19-55	28 44
	1 - 3/4Cx1/2 I.W.H. Stop & Waste		4 00		<u>NON-CHARGE</u>
	Trucking		75	Labor	33 85
			28 44	Labor	29 00
				10' 3/4" Copper tubing @ .384	3 84
				1 - 3/4" Corp Cock	4 33
				1 - Box & Rod	3 90
				9 x 3 Patching	9 00
				1 Offset tail piece	50
				1 Straight tail piece	50
					<u>84 92</u>

DATE \_\_\_\_\_

TOWN OF LEXINGTON — BOARD OF PUBLIC WORKS

WATER DIVISION

Sketch of Service Here

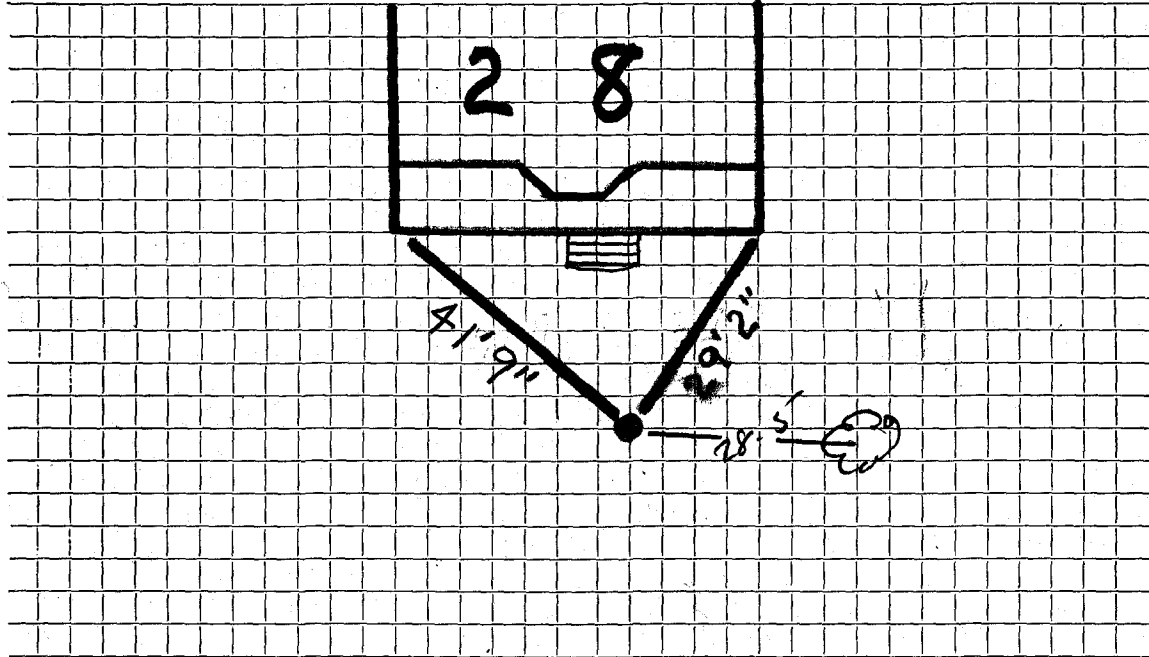

Connection made in ..... Street. Work completed .....

Remarks: .....

.....  
.....