

**WATER SERVICE RECORD**

Name **Donald J. Lynch**

Service No. **27**

Address **32 Muszey Street**

# **7086**

Location

~~Renewal~~ ~~New Service~~ **W.O. #7868**

Comm **6-3-63**


Date	Material	Amount	Total	Date	Amount
4-26-63	Labor	79.56		4-25-63	Deposit 150.00
	10% O.H.	7.96	87.52	6-3-63	Refund 31.77
37'	3/4" Copper tubing @.42		15.54		128.23
1	3/4" C x 1/2 I.W.H. Stop & Waste		6.17		NON CHARGE
2	hrs. Town Shovel @6.50		13.00	1	1/2 Straight tailpiece .50
2	hrs. Trucking @3.00		6.00	1	1/2 Offset tailpiece .50
			128.23		1.00

DATE \_\_\_\_\_

TOWN OF LEXINGTON — BOARD OF PUBLIC WORKS

WATER DIVISION

Sketch of Service Here

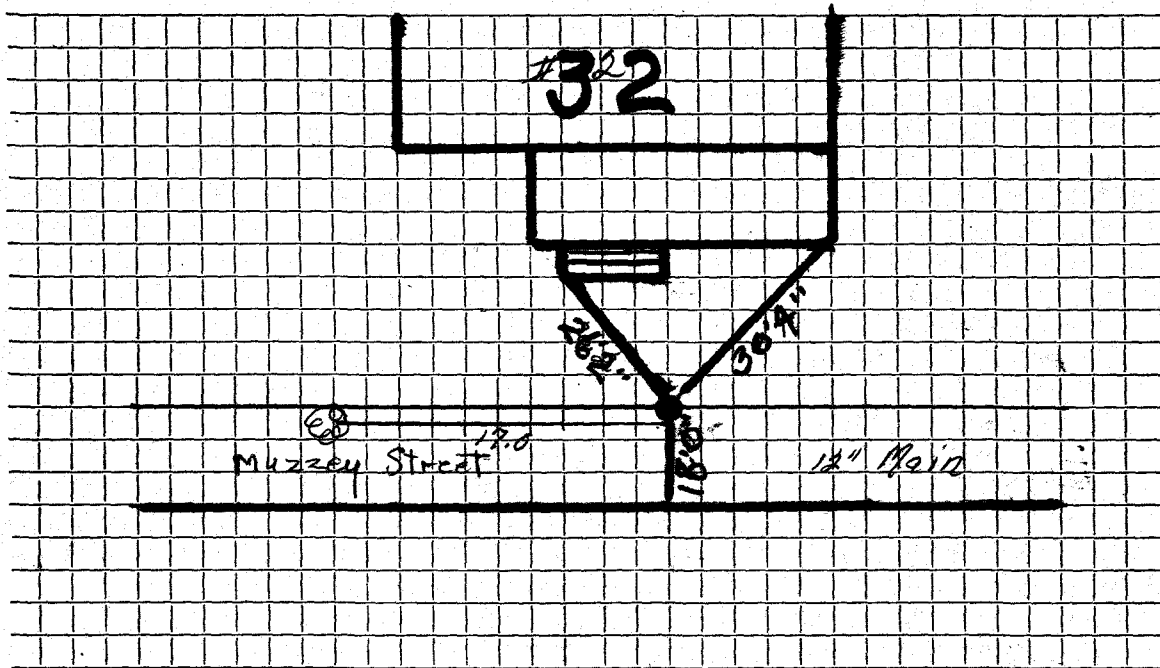

Connection made in ..... Street. Work completed .....

Remarks: .....

.....  
.....