

**WATER SERVICE RECORD**

Name *Woodhaven Realty*

Service No.

Address *33 MURREY ST. (19 FOREST)*

Location

Repair—Renewal—New Service *McLaughlin #0219*


| Date            | Material               | Amount | Total | Date | Amount |
|-----------------|------------------------|--------|-------|------|--------|
| <i>12-23-92</i> | <i>26 LF 1" COPPER</i> |        |       |      |        |
|                 | <i>1" CORP.</i>        |        |       |      |        |
|                 | <i>1" CURB</i>         |        |       |      |        |
|                 |                        |        |       |      |        |
|                 |                        |        |       |      |        |
| <i>12-30-92</i> | <i>90 LF 1" COPPER</i> |        |       |      |        |
|                 |                        |        |       |      |        |
|                 |                        |        |       |      |        |
DATE \_\_\_\_\_

# TOWN OF LEXINGTON — BOARD OF PUBLIC WORKS

## WATER DIVISION

Sketch of Service Here

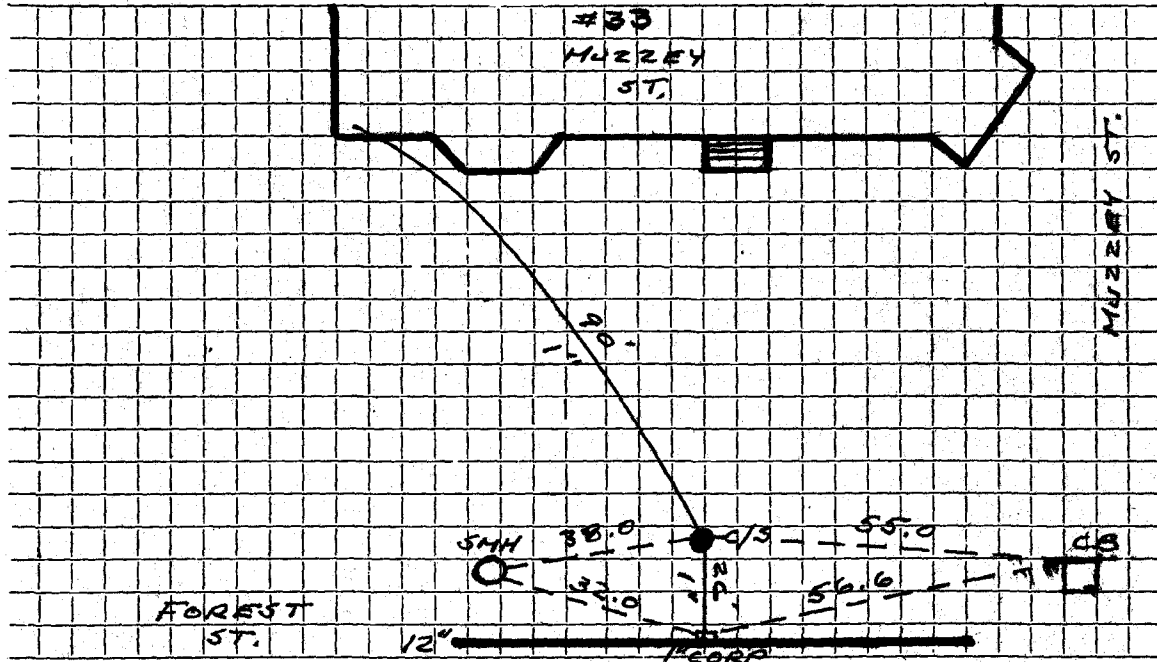

Connection made in FOREST Street. Work completed .....

Remarks: #19 FOREST = #33 MIZZERY .....