

WATER SERVICE RECORD

Name

Service No.

Address

#6 & #8 Muzzey Street

Location

~~Repair—Renewal—New Service~~ w.o.#77. (outside).


Date	Material	Amount	Total	Date	Amount
5-9-73	Labor	72.40			
5-16-73	"	20.13			
5-17-73	"	67.09	\$158.62		
	20' 3/4" Copper Pipe @.60		12.00		
	1 3/4" Corporation		9.57		
	1 3/4" Curb Stop		11.32		
	1 Box & Rod		5.10		
	1 3/4" Style 38 Repair Clamp				
	1 3/4 x 4" C.L. Nipple				
	1 1" x 3/4" Reducing Coupling				
	1 Trench 27' x 7'				
	5 Hrs. Trucking				
	3 Hrs. Pick up				
	1½ Hrs. Roller				
	2 Hrs. Town Shovel				
	2 Hrs. Compressor				

DATE _____

TOWN OF LEXINGTON — BOARD OF PUBLIC WORKS

WATER DIVISION

Sketch of Service Here

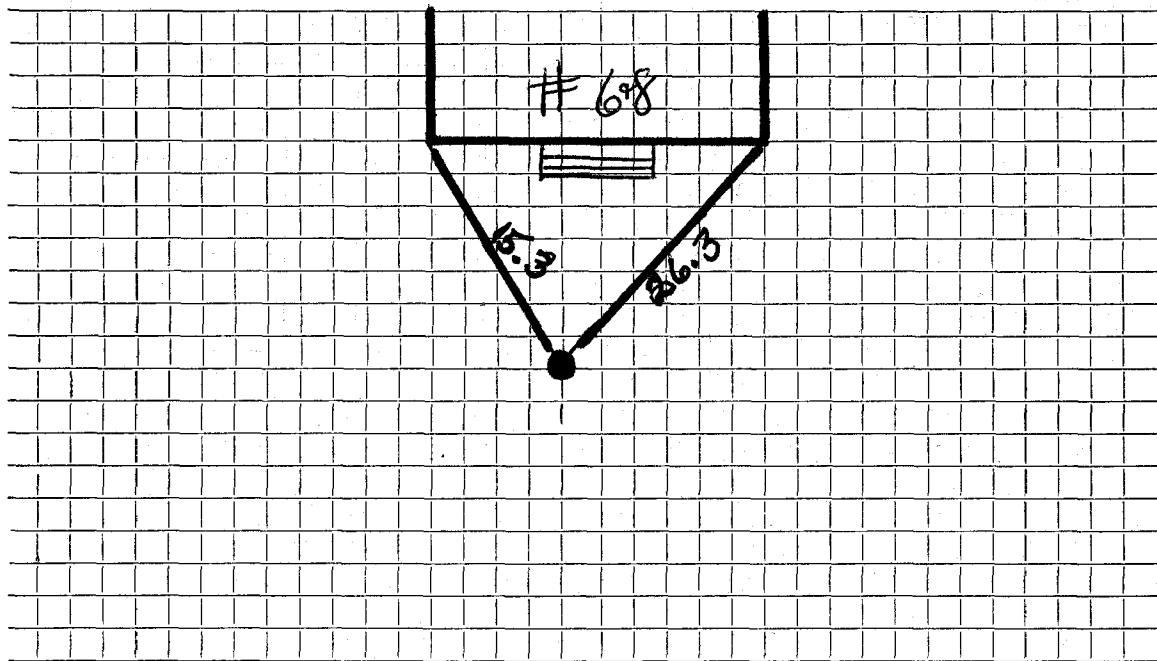

Connection made in Street. Work completed

Remarks:

.....

.....