

WATER SERVICE RECORD

Name Horseshoe Forge Realty

Service No. 259

Address 7 Muzzey Street

Location

~~XXXXXXXXXXXX~~ New Service

Comm 12-31-60


Date	Material	Amount	Total	Date		Amount
11-21-60	Labor	1.94		10-31-60	Deposit	60.00
	10% O.H.	.19	2.13	12-31-60	Refund	30.27
19'	1" Copper tubing @ .56		10.64			19.73
1	1" x 1" I.W.H. Stop & Waste		6.96		NON CHARGE	
			19.73	11-12-60	Labor	1.94
					15' 1" Copper tubing @ .56	8.40
					1 1" C Corp Cock	7.31
					1 1" C Curb Cock	8.06
					1 Box & Rod	4.90
					1 1" Straight tailpiece	.93
					1 1" Offset tailpiece	.93
						32.47

TOWN OF LEXINGTON — BOARD OF PUBLIC WORKS

WATER DIVISION

Sketch of Service Here

7 MUZZEY ST

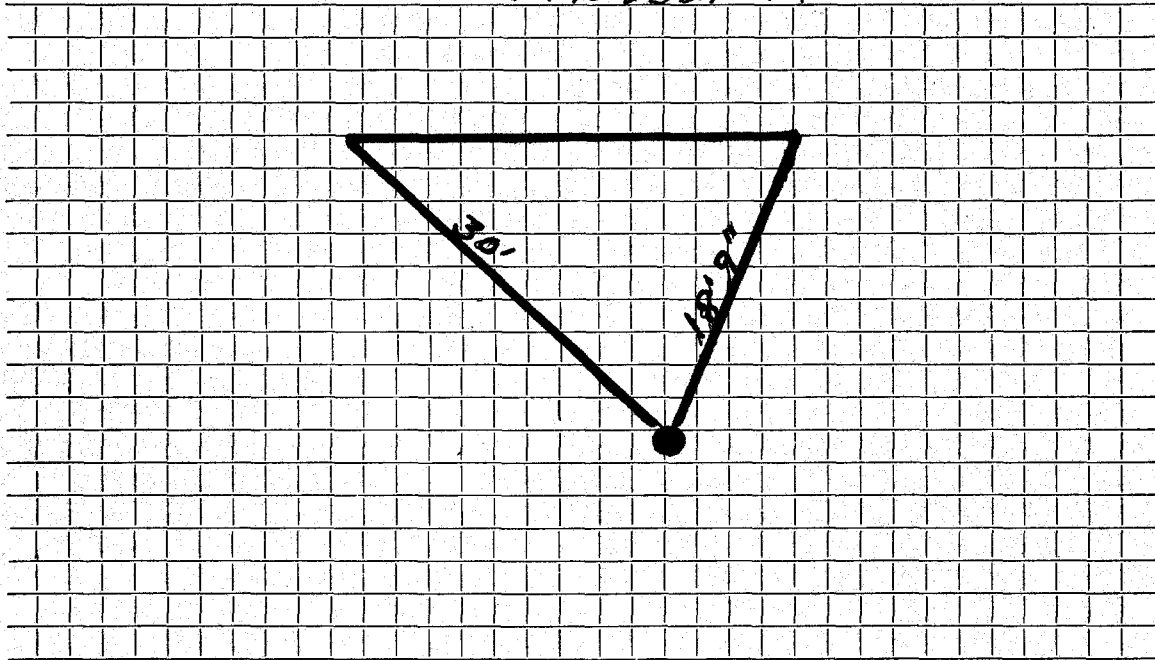

Connection made in Street. Work completed

Remarks:
.....
.....