

Name **Fulton Brown**

Service No. **15 3070**

Address **24 Arlington Street**

9 Muzzey St.
Winchester, Mass.

Location **9 Muzzey Street**

Kind of Pipe

Size

Size of Main

~~Repair - Renewal~~ - New Service

Location

Date	Material	Amount	Total	Date	Amount
Aug. 25, '45	Labor	1 05	1 05	Aug. 13 '45	40 00
	10% Overhead		11	Oct 4 '45	20 32
	70' - $\frac{3}{4}$ " Copper Tubing		13 38		19 68
	1 - $\frac{3}{4}$ " C x $\frac{3}{4}$ " I.W.H. Stop & Waste		2 35		
	1 - $\frac{3}{4}$ " x $\frac{1}{2}$ " Bushing		29	Aug. 25, '45	Labor 90
	1 Union		<u>2 50</u>	13' - $\frac{3}{4}$ " Copper Tubing	2 49
			19 68	1 - $\frac{3}{4}$ " C Corp-cock	2 48
	(Water & Sewer Service in same			1 - $\frac{3}{4}$ " C x $\frac{3}{4}$ " C Curb-cock	2 75
	Trench Labor on Sewer Service Card)			1 Box & Rod	<u>1 65</u>
					10 27
	Labor				

Deposited
Refunded

Non-Charge

Refund sent 10-1-45

Hadley Press, Inc., Lexington

DATE _____

TOWN OF LEXINGTON—BOARD OF PUBLIC WORKS

WATER DIVISION

The undersigned applies for a supply of water at No. _____ St. and hereby agrees to comply with the rules and regulations as now, or at any future time, established by the Board of Selectmen.

Am't. of Estimate \$ _____

Owner

Tuller Brown

Am't. Paid \$ _____

Address


9 Muzzey St.

Lexington, Mass.

Builder _____

Sketch of Service Here

9 MUZZEY

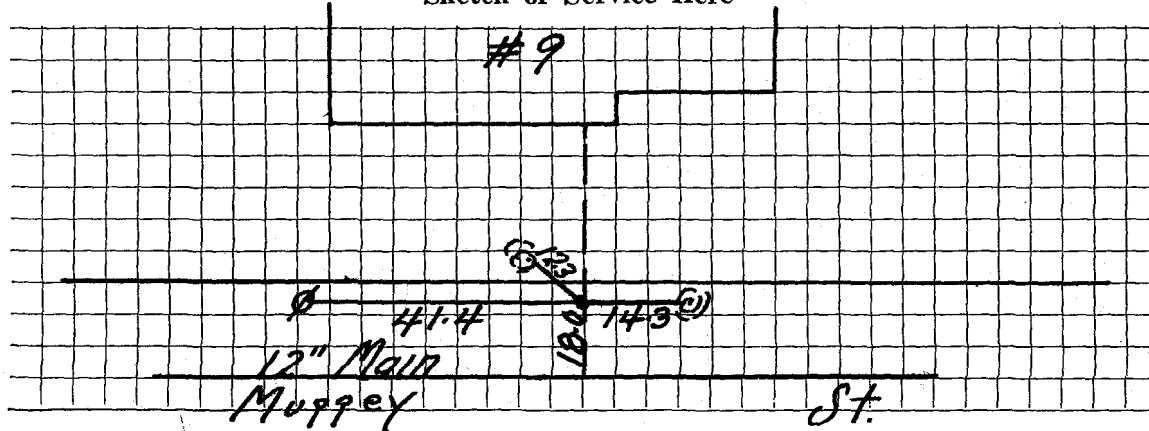

Connection made in _____ Street.

Work completed _____ 19

Remarks: