

Name Henry J. Moulton

Service No. 59

6797

Address 10 Myrna Road

Lexington, Mass.

Location 10 Myrna Road

Kind of Pipe

Size

Size of Main

~~REPAIR GENERAL~~—New Service

Com 5/2/50

Location

Date	Material	Amount	Total	Date	Location	Amount
May 4, '50	Labor	1 30	1 30	April 15, 50	Deposited	15 00
	10% Overhead		13	June 15, 50	Paid	68
	27' - 3/4" Copper Tubing @.23	6 21	6 21		No Charge	15 68
	1 - 3/4" C x 1/2" I.W.H. S&W	3 29	3 29	May 4, '50	Labor	6 10
	Trucking 1 hr. @.75	75	75	16' - 3/4" Copper Tubing @.23		3 68
	Patching 4 x 3	4 00	4 00	1 - 3/4" C Corp-cock		3 15
			15 68	1 - 3/4" C x 3/4" C Curb-cock		3 85
				1 - Box & Rod		3 70
				1 - 1/2" Straight Tail Piece		38
				1 - 1/2" Offset Tail Piece		38
				Littlefield Shovel 1 hr. @ 7.00		7 00
				Trucking 1 hr. @.75		75
	Labor					28 99

Bill sent 5/2/50

DATE _____

TOWN OF LEXINGTON - BOARD OF PUBLIC WORKS

WATER DIVISION

The undersigned applies for a supply of water at No..... St. and hereby agrees to comply with the rules and regulations as now, or at any future time, established by the Board of Selectmen.

Am't of Estimate \$.....

Owner


Am't Paid \$.....

Address

Builder

.....

Sketch of Service Here

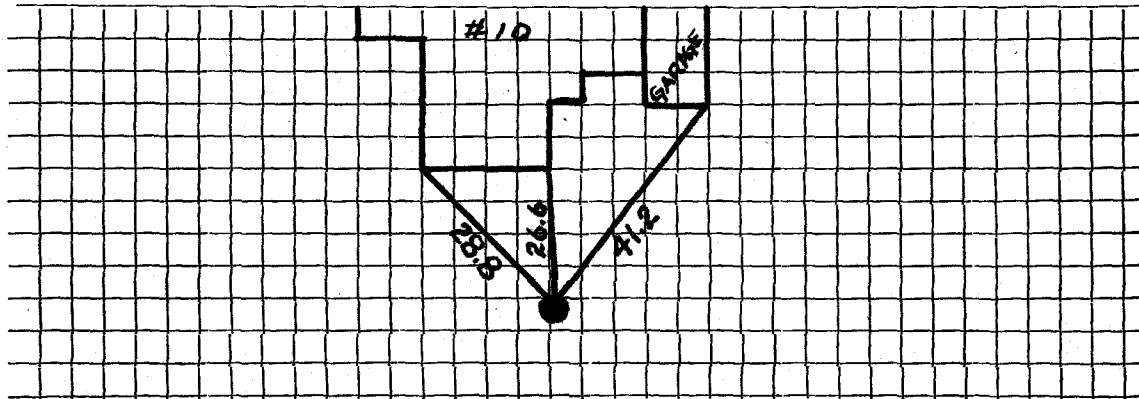

Connection made in Street.

Work completed19

Remarks: