

Name Leeland Construction Company

Service No. 152

Address 11 Myrna Road

3562

Lexington

Location 11 Myrna Road

Kind of Pipe

Size

Size of Main

~~Repair~~ - New Service

Com. 9-5-50

Location

Date	Material	Amount	Total	Date	Amount
July 7 '50	Labor	4 00		June 29 '50	50 00
	10% Overhead	40	4 40	<i>Deposited</i>	
	38' - 3/4" Copper Tubing @ 23¢		8 74		36 18
	1 - 3/4"C x 1/2" I.W.H. S&W		3 29	No Charge	
	1 hr. Littlefield Shovel		7 00	July 7 '50 Labor	5 87
	1 hr. Trucking		75	17' - 3/4" Copper Tubing @ 23¢	3 91
	Patching 12 x 3		12 00	1 - 3/4"C. Corp-cock	3 15
			36 18	1 - 3/4"C x 3/4"C Curb-cock	3 85
				1 Box & Rod	3 35
				1 - 1/2" Offset Tail Piece	38
				1 - 1/2" Straight Tail Piece	38
				2 hrs. Littlefield Shovel	14 00
	Labor			1 hr. Trucking	75
					35 64

Hadley Press, Inc., Lexington

DATE _____

TOWN OF LEXINGTON—BOARD OF PUBLIC WORKS

WATER DIVISION

The undersigned applies for a supply of water at No. _____ St. and hereby agrees to comply with the rules and regulations as now, or at any future time, established by the Board of Selectmen.

Am't. of Estimate \$ _____


Owner _____

Am't. Paid \$ _____

Address _____

Builder _____

Sketch of Service Here

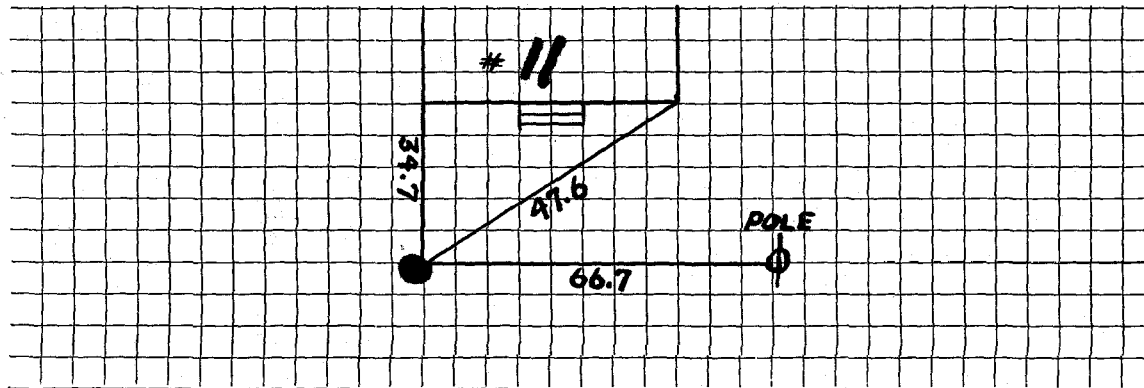

Connection made in _____ Street.

Work completed _____ 19

Remarks: