

Name **Island Construction Company**Service No. **152**Address **2 Myrna Road**

363

Lexington

Location **2 Myrna Road**

6513

Kind of Pipe

Size

Size of Main

~~Repair-Replace~~ **New Service**

Com. 9-5-50

Location

Date	Material	Amount	Total	Date	Amount
July 7 '50	Labor	1 30		June 29 '50	46 00
	10% Overhead	13	1 43	<i>Deposited</i>	
	36' - 3/4" Copper Tubing @ 23¢	8 28			31 14
	1 - 3/4" C x 1/2" I.W.H. S&W	3 29		No Charge	
	1 - 3/4" C x 3/4" C Union (3 pts)	1 39		July 7 '50 Labor	1 99
	1 hr. Littlefield Shovel	7 00		14' - 3/4" Copper Tubing @ 23¢	3 22
	1 hr. Trucking	75		1 - 3/4" C Corp-cock	3 15
	Patching 9 x 3	9 00		1 - 3/4" C x 3/4" C Curb-cock	3 85
		31 14		1 Box & Rod	3 35
				1 - 1/2" Offset Tail Piece	38
				1 - 1/2" Straight Tail Piece	38
				1 hr. Littlefield Shovel	7 00
	Labor			1 hr. Trucking	75
					24 07

DATE _____

TOWN OF LEXINGTON - BOARD OF PUBLIC WORKS

WATER DIVISION

The undersigned applies for a supply of water at No..... St. and hereby agrees to comply with the rules and regulations as now, or at any future time, established by the Board of Selectmen.

Am't of Estimate \$.....

Owner


Am't Paid \$.....

Address

Builder

.....

Sketch of Service Here

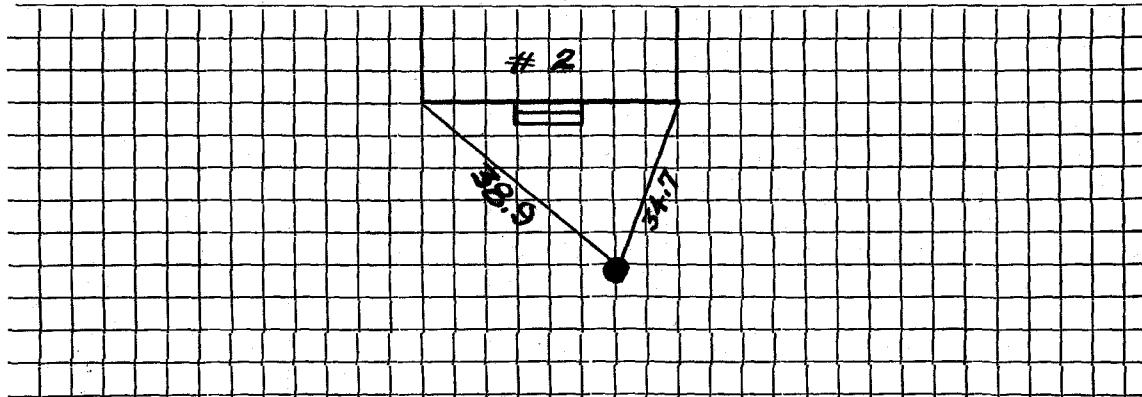

Connection made in Street.

Work completed19

Remarks: