


DATE _____

TOWN OF LEXINGTON — BOARD OF PUBLIC WORKS

WATER DIVISION

Sketch of Service Here

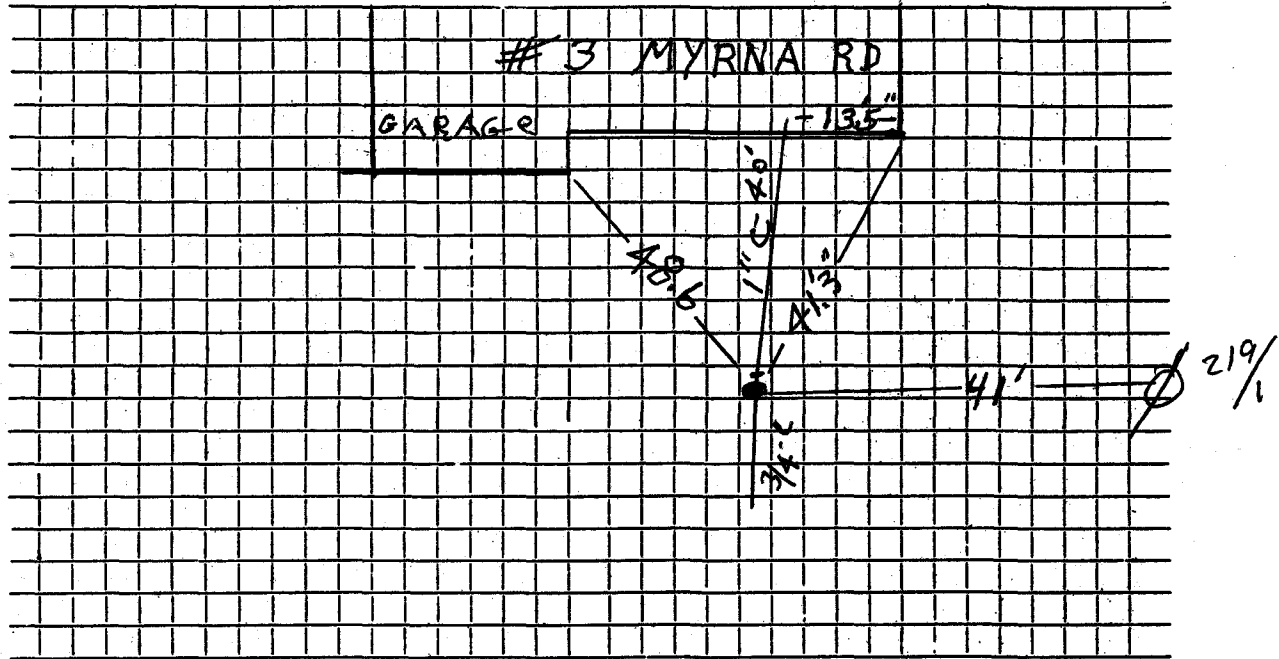

Connection made in Street.

Work completed ... 11/9/06 ... J-McLaughlin

Remarks:
.....
.....