

Name Leeland Construction Company

Service No. 152

Address 4 Myrna Road

4903
6422

Lexington

Location 4 Myrna Road

Kind of Pipe

Size

Size of Main

~~Repair~~ ~~Renewal~~ New Service

Com. 9-5-50

Location

Date	Material	Amount	Total	Date	Amount	
July 7 '50	Labor	1 30		<i>June 29 '50</i>	<i>Deposited</i>	35 00
	10% Overhead	13	1 43			
	30' - 3/4" Copper Tubing @ 23¢		6 90			27 37
	1 - 3/4" C x 1/2" I.W.H. S&W		3 29		No Charge	
	1 hr. Littlefield Shovel		7 00	July 7 '50	Labor	1 99
	1 hr. Trucking		75		12' - 3/4" Copper Tubing @ 22¢	2 76
	Patching 8 x 3		8 00		1 - 3/4" C Corp-cock	3 15
			27 37		1 - 3/4" C x 3/4" C Curb-cock	3 85
					1 Box & Rod	3 35
					1 - 1/2" Offset Tail Piece	38
					1 - 1/2" Straight Tail Piece	38
					1 hr. Littlefield Shovel	7 00
	Labor				1 hr. Trucking	75
						23 61

Hadley Press, Inc., Lexington

DATE _____

TOWN OF LEXINGTON—BOARD OF PUBLIC WORKS

WATER DIVISION

The undersigned applies for a supply of water at No. _____ St. and hereby agrees to comply with the rules and regulations as now, or at any future time, established by the Board of Selectmen.

Am't. of Estimate \$ _____


Owner _____

Am't. Paid \$ _____

Address _____

Builder _____

Sketch of Service Here

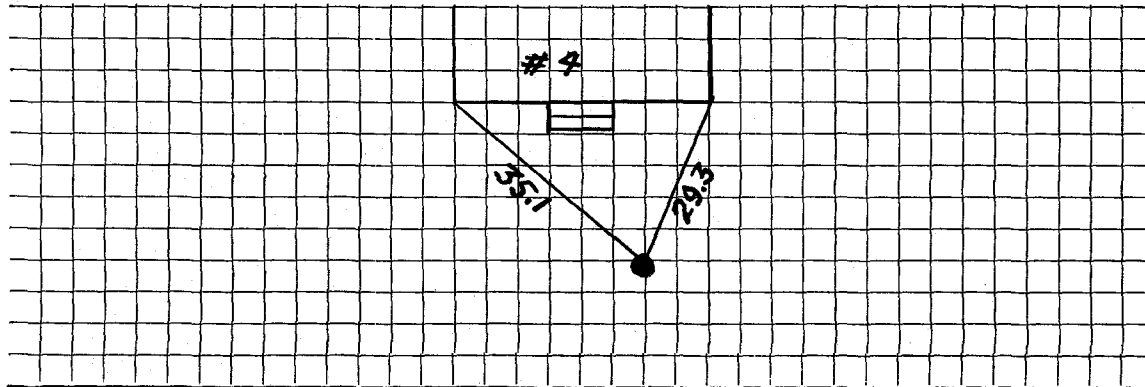

Connection made in _____ Street.

Work completed _____ 19

Remarks: