

Name Henry Moulton

Service No. 131

36

Address 6 Myrna Road

Lexington

Location

6 Myrna Road

Kind of Pipe

Size

Size of Main

~~Repair~~ ~~Renewal~~ - New Service

Com. 9-5-50

Location

Date	Material	Amount	Total	Date	Amount
July 5 '50	Labor	4 00		June 14 '50	13 00
	10% Overhead	40	4 40	Sept 11 '50	12 72
	36' - 3/4" Copper Tubing @ 23¢	8 28			27 72
	1 - 3/4" C x 1/2" I.W.H. S&W	3 29			No Charge
	1 hr. Littlefield Shovel	7 00		July 5 '50	Labor 7 50
	1 hr. Trucking		75		9' - 3/4" Copper Tubing @ 23¢ 2 07
	Patching 4 x 3		4 00		1 - 3/4" C. Corp-cock 3 15
			27 72		1 - 3/4" C x 3/4" C Curb-cock 3 85
					1 Box & Rod 3 35
					1 - 1/2" Offset Tail Piece 38
					1 - 1/2" Straight Tail Piece 38
					1 hr. Littlefield Shovel 7 00
	Labor				1 hr. Trucking 75
					28 43

Bill sent 9-8-50

DATE _____

TOWN OF LEXINGTON – BOARD OF PUBLIC WORKS

WATER DIVISION

The undersigned applies for a supply of water at No..... St. and hereby agrees to comply with the rules and regulations as now, or at any future time, established by the Board of Selectmen.

Am't of Estimate \$.....

Owner


Am't Paid \$.....

Address

Builder

.....

Sketch of Service Here

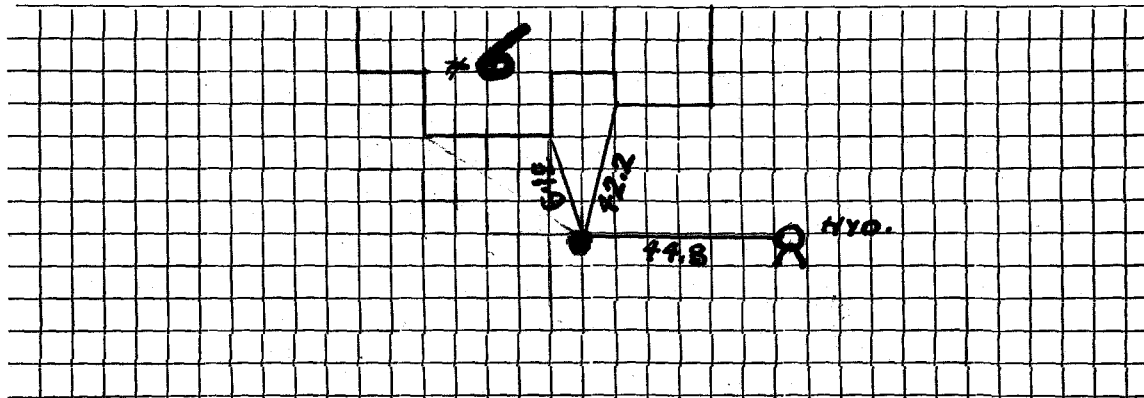

Connection made in Street.

Work completed19

Remarks: