

Name Leeland Construction Company

Service No. 21

Address 7 Myrna Road

#7540

Lexington

Location 7 Myrna Road

Kind of Pipe

Size

Size of Main

~~Repair-Renewal~~—New Service

Com. 4-17-50

Location

Date	Material	Amount	Total	Date	Amount
Feb. 27 '50	Labor	3 67		Feb. 13 '50	35 00
	10% Overhead	37	4 04	April 20 '50	791
	37'- 3/4" Copper Tubing @ 23¢		8 51		27 07
	1- 3/4" C x 1/2" I.W.H. S & W		3 29		Non-Charge
	1 hr. Trucking @ 75¢		75	Feb. 27 '50	Labor 3 68
	1 1/2 hrs. Littlefield		10 50		26'- 3/4" Copper Tubing @ 23¢ 5 98
			27 09		1- 3/4" C. Corp-cock 3 15
					1- 3/4" C x 3/4" C Curb-cock 3 85
					1- 3/4" C x 3/4" C Union (3 parts) 1 39
					1 Box & Rod 3 70
					1- 1/2" Offset Tail Piece 38
					1- 1/2" Straight Tail Piece 38
	Labor				2 1/2 hrs. Littlefield 17 50
					1 hr. Trucking 75
					40 76

DATE \_\_\_\_\_

TOWN OF LEXINGTON - BOARD OF PUBLIC WORKS  
**WATER DIVISION**

The undersigned applies for a supply of water at No..... St. and hereby agrees to comply with the rules and regulations as now, or at any future time, established by the Board of Selectmen.

Am't of Estimate \$.....

Owner .....


Am't Paid \$.....

Address .....

Builder .....

.....

Sketch of Service Here

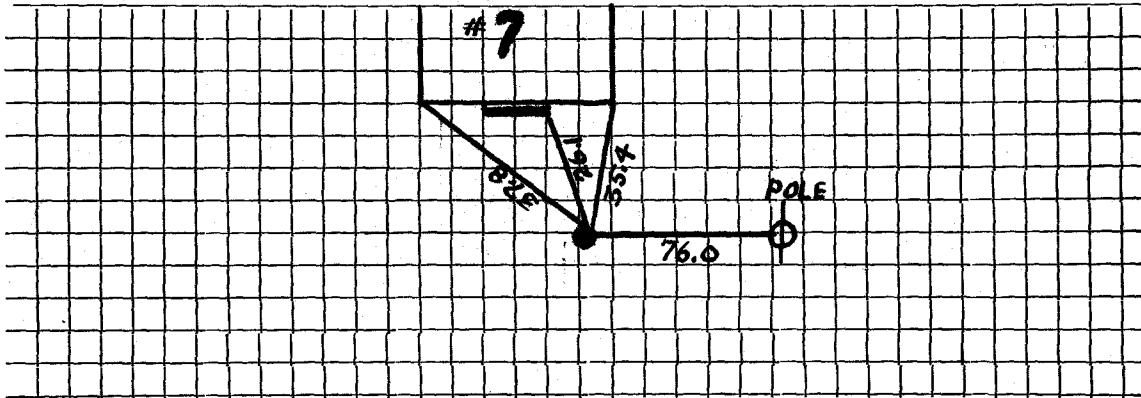

Connection made in ..... Street.

Work completed .....19

Remarks: