

Name Henry J. Moulton

Service No. 58

Address 8 Myrna Road

FF 6915

Lexington, Mass.

Location 8 Myrna Road

Kind of Pipe

Size

Size of Main

~~XXXXXX~~ New Service

Com. 5/22/50

Location

Date	Material	Amount	Total	Date	Amount
May 4, '50	Labor	1 30	1 30	April 18 '50	15 00
	10% Overhead		13	June 15 '50	68
	27' - 3/4" Copper Tubing @.23	6 21	6 21		15 68
	1 - 3/4" C x 1/2" I.W.H. S&W	3 29	3 29	May 4, '50	6 10
	Trucking 1 hr. @.75	75	75	16' - 3/4" Copper Tubing @.23	3 68
	Patching 4 x 3	4 00	4 00	1 - 3/4" C Corp-cock	3 15
			15 68	1 - 3/4" C x 3/4" C Curb-cock	3 85
				1 - Box & Rod	3 70
				1 - 1/2" Straight Tail Piece	38
				1 - 1/2" Offset Tail Piece	38
				Littlefield Shovel 1 hr. @ 7.00	7 00
				Trucking 1 hr. @.75	75
					28 99

Bill sent 5/24/50

Labor

Deposited
Paid

No Charge

DATE _____

TOWN OF LEXINGTON – BOARD OF PUBLIC WORKS

WATER DIVISION

The undersigned applies for a supply of water at No..... St. and hereby agrees to comply with the rules and regulations as now, or at any future time, established by the Board of Selectmen.

Am't of Estimate \$.....

Owner


Am't Paid \$.....

Address

Builder

.....

Sketch of Service Here

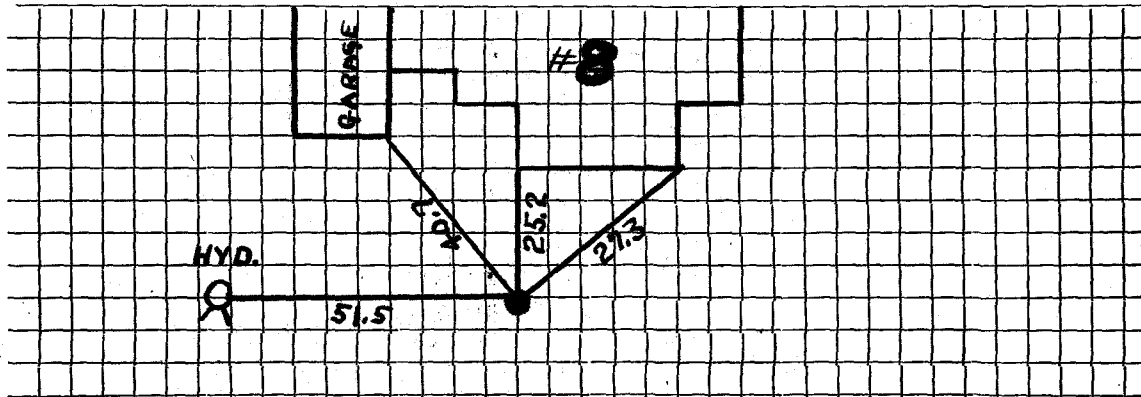

Connection made in Street.

Work completed19

Remarks: