

Name Leeland Construction Company

Service No. 152

Address 9 Myrna Road

4555

Lexington

Location 9 Myrna Road

Kind of Pipe

Size

Size of Main

~~Repair-Renewal~~ New Service

Com. 9-5-50

Location

Date	Material	Amount	Total	Date	Amount
July 7 '50	Labor	4 00		June 29 '50	50 00
	10% Overhead	40	4 40	<i>Deposited</i>	
	42' - 3/4" Copper Tubing @ 23¢		9 66		42 49
	1 - 3/4"C x 1/2" I.W.H. S&W		3 29		No Charge
	1 - 3/4"C x 3/4"C Union (3 pts)		1 39	July 7 '50	Labor 5 87
	1 hr. Littlefield Shovel		7 00		21' - 3/4" Copper Tubing @ 23¢ 4 83
	1 hr. Trucking		75		1 - 3/4"C Corp-cock 3 15
	Patching 16 x 3		16 00		1 - 3/4"C x 3/4"C Curb-cock 3 85
			42 49		1 Box & Rod 3 35
					1 - 1/2" Offset Tail Piece 38
					1 - 1/2" Straight Tail Piece 38
					2 hrs. Littlefield Shovel 14 00
	Labor				1 hr. Trucking 75
					36 56

DATE _____

TOWN OF LEXINGTON—BOARD OF PUBLIC WORKS

WATER DIVISION

The undersigned applies for a supply of water at No. _____ St. and hereby agrees to comply with the rules and regulations as now, or at any future time, established by the Board of Selectmen.

Am't. of Estimate \$ _____


Owner _____

Am't. Paid \$ _____

Address _____

Builder _____

Sketch of Service Here

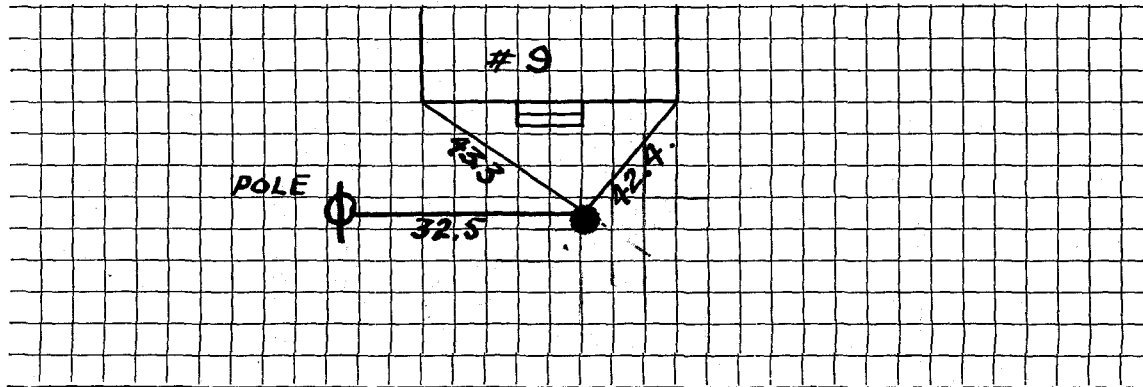

Connection made in _____ Street.

Work completed _____ 19

Remarks: