




TOWN OF LEXINGTON — BOARD OF PUBLIC WORKS

WATER DIVISION

Sketch of Service Here

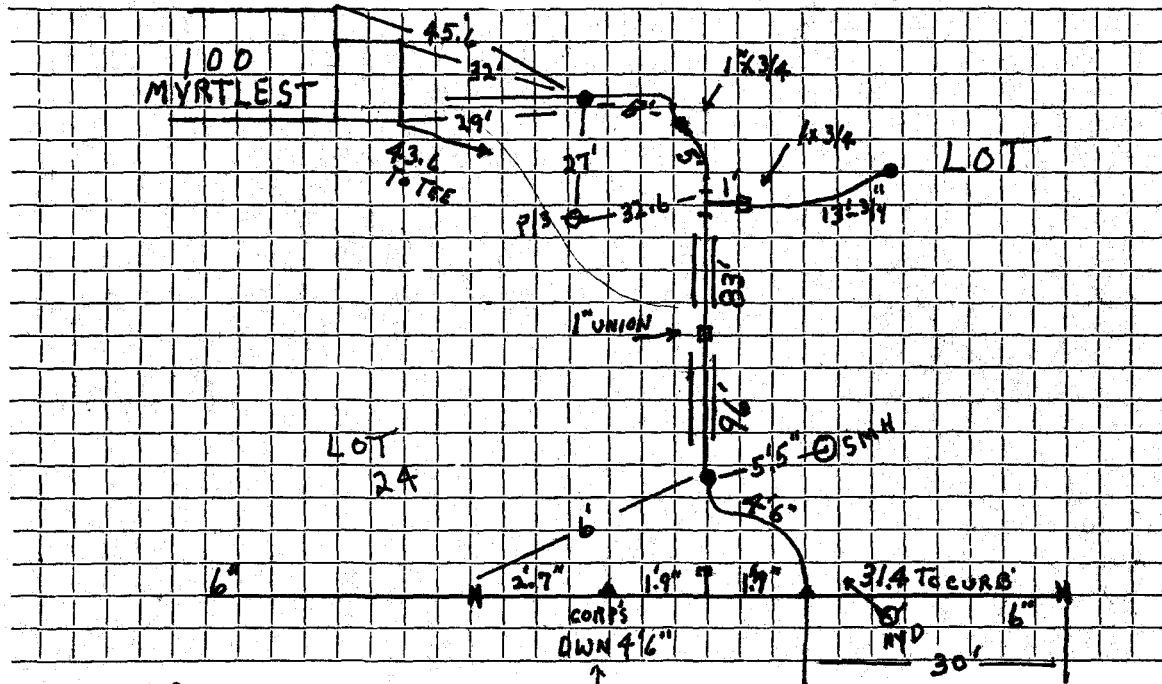

Connection made in VALLEY RD. Street. FOR COR Work completed

Remarks: 6" MAIN USED AS SLEEVE FOR 1" SERVICE. LOT 24