

WATER SERVICE RECORD

Name Joseph Chisholm

Service No. 252

Address 76 Myrtle Street

7228

Location

~~Repair - Renewal~~ - New Service

Comm 12-14-59


Date	Material	Amount	Total	Date	Amount
10-11-59	Labor	1 85		10-6-59	Deposit 50 00
	10% O. H.	19	2 04	12-14-59	Refund 20 33
50'	3/4" Copper tubing @.42		21 00		29 67
1	3/4" C x 1/2 I.W.H. Stop & Waste	5 88			NON CHARGE
1	Hr. Trucking @.75		75	10-11-59	Labor 1 61
			29 67	10'	3/4" copper tubing @.42 4 20
				1	3/4" C Corp Cock 4 67
				1	3/4" C Curb Cock 5 98
				1	Box & Rod 4 90
				1	1/2 Straight Tailpiece 50
				1	1/2 Offset Tailpiece 50
					22 26

DATE _____

TOWN OF LEXINGTON — BOARD OF PUBLIC WORKS

WATER DIVISION

Sketch of Service Here

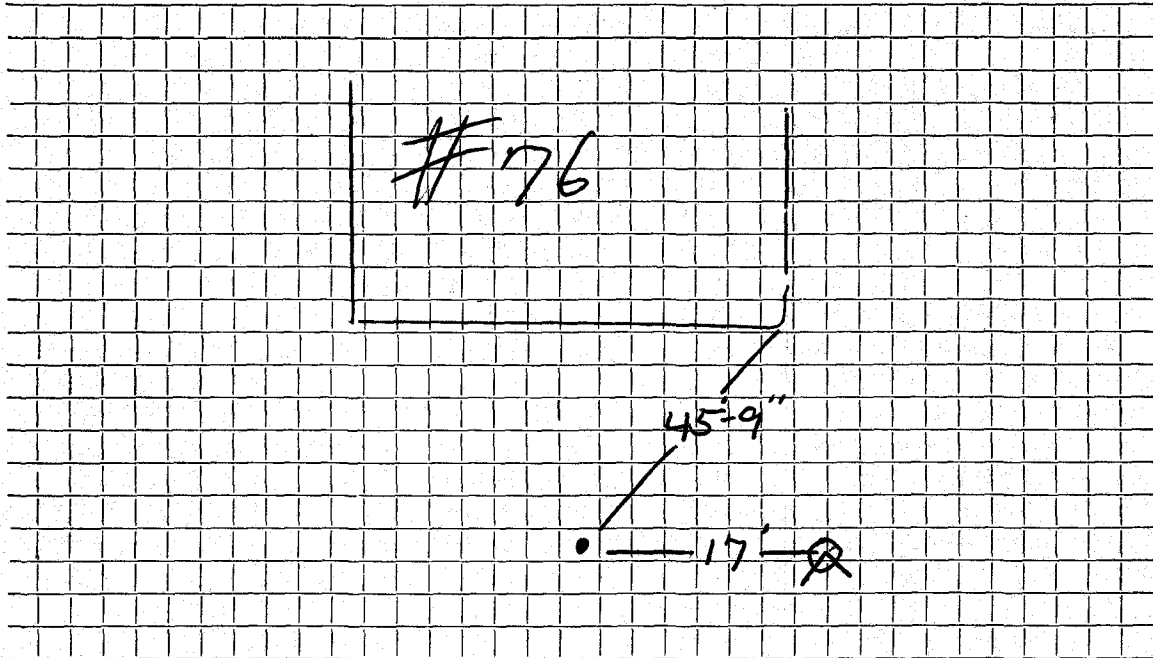

Connection made in Street. Work completed

Remarks:
.....
.....