


TOWN OF LEXINGTON — BOARD OF PUBLIC WORKS

WATER DIVISION

Sketch of Service Here

6" To 4" MAIN FEED FROM BARRYMEAD DR

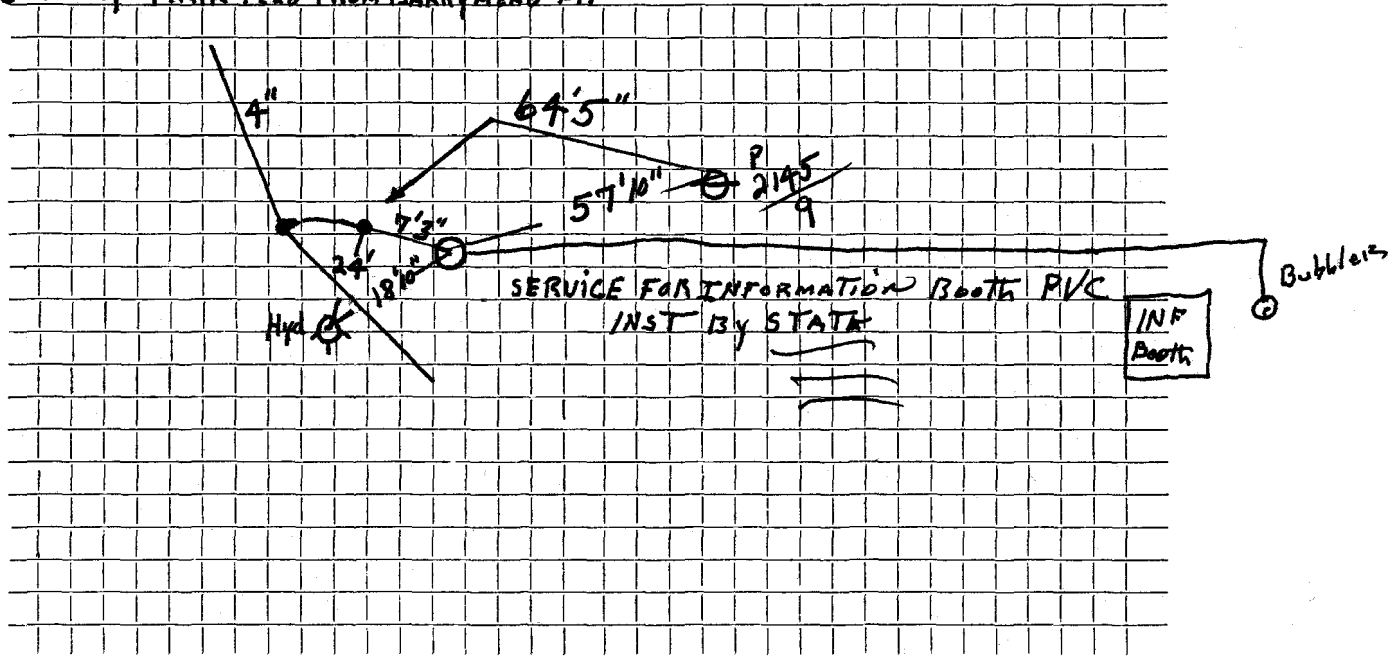

Connection made in Street. Work completed

Remarks: GAS STA. FEED FROM INSIDE ROY ROGERS


TOWN OF LEXINGTON — BOARD OF PUBLIC WORKS

WATER DIVISION

Sketch of Service Here

DEC 1994

RT 128

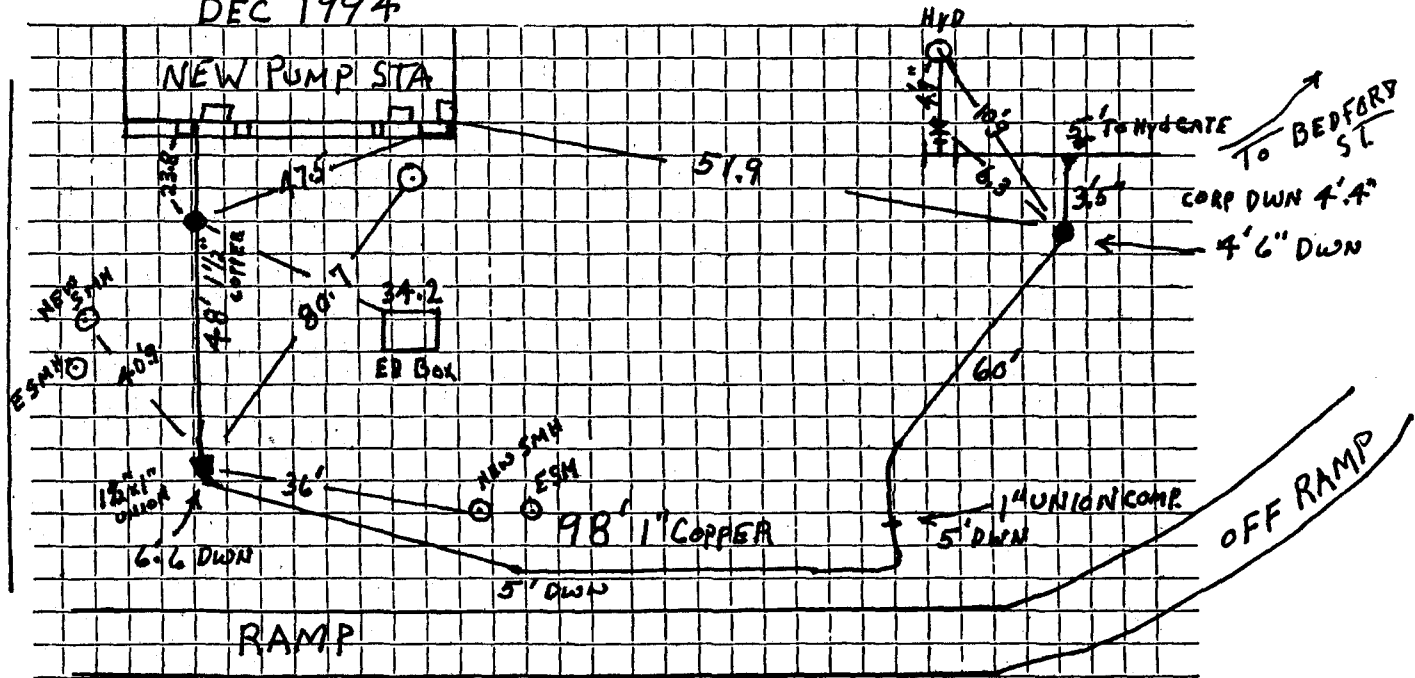

Connection made in Street. Work completed

Remarks: 1 1/2" UNION IS ON TOP OFF 6" WATER MAIN BY ABANDONED 1 1/2" CORR.