




DATE 11/6/2017

TOWN OF LEXINGTON — BOARD OF PUBLIC WORKS

WATER DIVISION

Sketch of Service Here

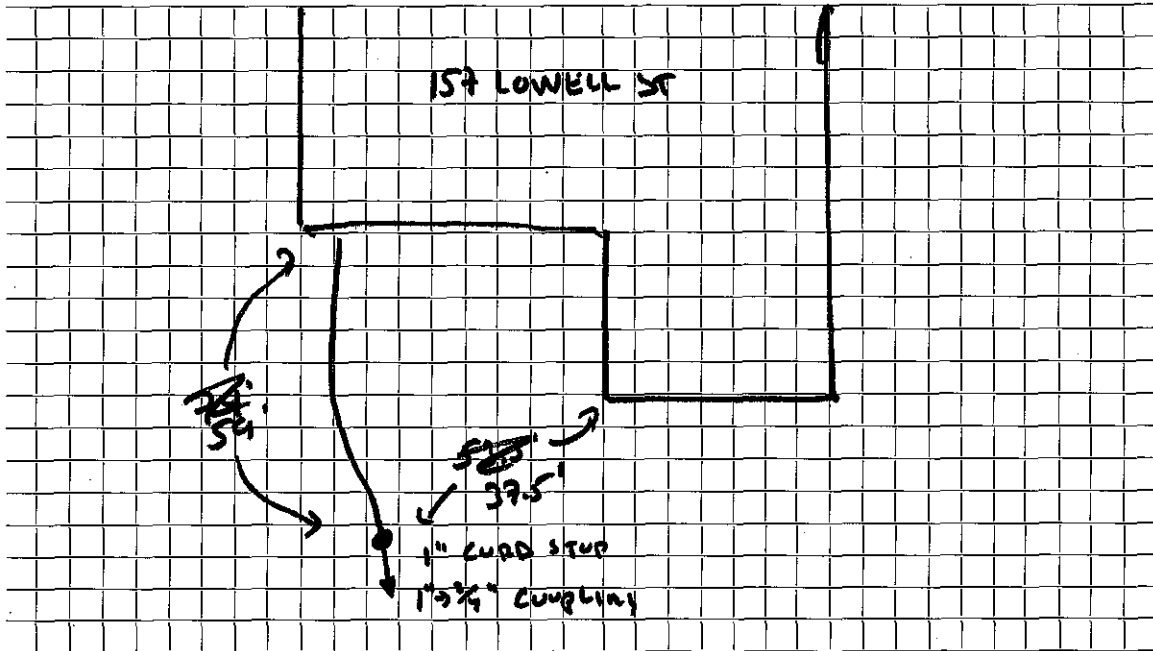

Connection made in ..... Street.

Work completed ..... DAVID SANTO CONT. ....

Remarks: .. BURIED 3/4" CURD, LEFT ON .....