

Name Gurich Associates

Service No.

47

Address 11 Nichols Road

# 3930

Lexington, Mass.

Location 11 Nichols Road

Kind of Pipe

Size

Size of Main

~~REGULAR~~ New Service

Com. 5-2-49

Location

Date	Material	Amount	Total	Date	Amount
Apr. 11, '49	Labor	1 25	1 25	April 5 '49	20 06
	10 % Overhead		13		59
	40' - 3/4" Copper Tubing @.27	10 80			17 61
	1 - 3/4" C x 1/2" I.W.H. S&W	3 29		Apr. 11, '49	5 85
	1 - 3/4" C x 3/4" C Union (3pts)	1 39		14' - 3/4" Copper Tubing @.27	3 78
	Trucking 1 hr. @.75	75		1 - 3/4" C Corp-cock	3 15
			17 61	1 - 3/4" C x 3/4" C Curb-cock	3 85
				1 - Bpx & Rod	3 95
				1 - 1/2" Offset Tail Piece	37
				1 - 1/2" Straight Tail Piece	37
				Littlefield Shovel 2 hrs. @7.00	14 00
				Trucking 1 hr. @.75	75
	Labor				36 07

DATE \_\_\_\_\_

TOWN OF LEXINGTON - BOARD OF PUBLIC WORKS

**WATER DIVISION**

The undersigned applies for a supply of water at No..... St. and hereby agrees to comply with the rules and regulations as now, or at any future time, established by the Board of Selectmen.

Am't of Estimate \$.....

Owner .....


Am't Paid \$.....

Address .....

Builder .....

.....

Sketch of Service Here

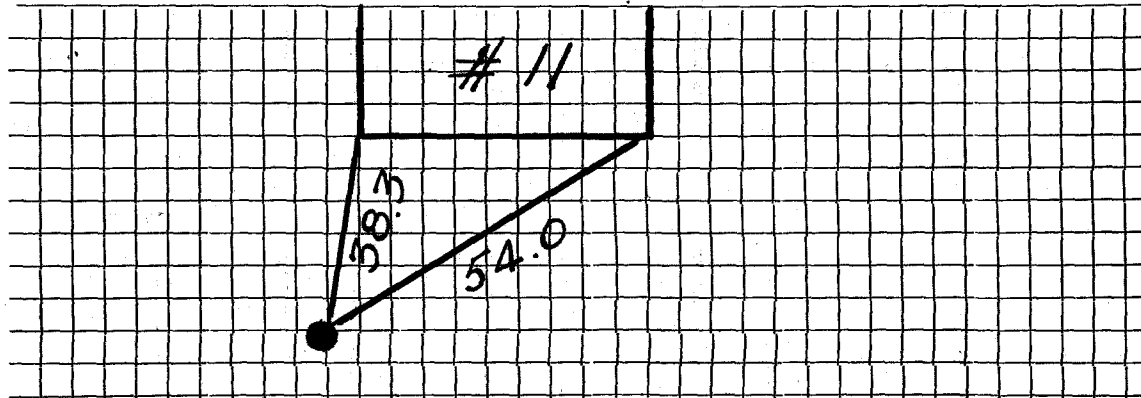

Connection made in ..... Street.

Work completed .....19

Remarks: